


STATE OF KANSAS
STATE CORPORATION COMMISSION

Give All Information Completely
Make Required Affidavit
Mail or Deliver Report to:
Conservation Division
State Corporation Commission
800 Bitting Building
Wichita, Kansas

WELL PLUGGING RECORD

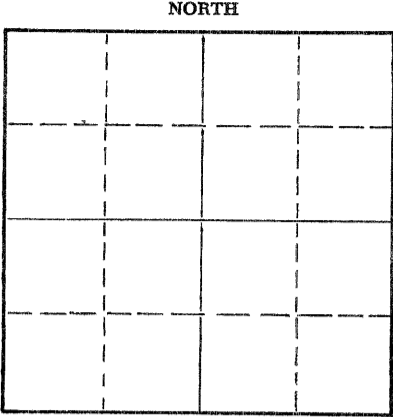

Rocks _____ County. Sec. 31 Twp. 8s Rge. _____ (E) 18 (W)
Location as "NE/CNW&SW¼" or footage from lines. NE NE SE/4
Lease Owner Herman Geo. Kaiser
Lease Name Hennesy Well No. 1
Office Address 908 Palace Building - Tulsa 3, Oklahoma
Character of Well (completed as Oil, Gas or Dry Hole) Dry Hole
Date well completed Nov. 21 19 55
Application for plugging filed Nov. 21 19 55
Application for plugging approved Nov. 21 19 55
Plugging commenced Nov. 21 19 55
Plugging completed Nov. 21 19 55
Reason for abandonment of well or producing formation dry

If a producing well is abandoned, date of last production none 19 _____
Was permission obtained from the Conservation Division or its agents before plugging was commenced? Yes

Name of Conservation Agent who supervised plugging of this well Eldon Petty
Producing formation _____ Depth to top _____ Bottom _____ Total Depth of Well 3525 Feet
Show depth and thickness of all water, oil and gas formations.

OIL, GAS OR WATER RECORDS

CASING RECORD

FORMATION	CONTENT	FROM	TO	SIZE	PUT IN	PULLED OUT
				8 5/8"	208'	None

Describe in detail the manner in which the well was plugged, indicating where the mud fluid was placed and the method or methods used in introducing it into the hole. If cement or other plugs were used, state the character of same and depth placed, from _____ feet to _____ feet for each plug set.

Circulated hole with heavy mud, set cementing plug at 208' with 1/2 sack hulls and 15 sacks cement. Mudded hole to 35', set cementing plug and 1/2 sack Hulls and 10 sacks cement to bottom of cellar.

JAN 7 1956
CONSERVATION DIVISION
WICHITA, KANSAS

(If additional description is necessary, use BACK of this sheet)
Name of Plugging Contractor H-30, Inc.
Address 710 Petroleum Bldg., Wichita, Kansas

STATE OF Kansas, COUNTY OF Sedgwick, ss. employee of Contractor L. C. Sponenberg (employee of owner) or (owner or operator) of the above-described well, being first duly sworn on oath, says: That I have knowledge of the facts, statements, and matters herein contained and the log of the above-described well as filed and that the same are true and correct. So help me God.

(Signature) L. C. Sponenberg
(Address) _____

SUBSCRIBED AND SWORN to before me this 28th day of November, 19 55

My commission expires February 13, 1956
Rose Jurey Notary Public.

PLUGGING
FILE SEC 31 T 8 R 18W
BOOK PAGE 19 LINE 43

KANSAS GEOLOGICAL SOCIETY
KANSAS WELL LOG BUREAU - KANSAS WELL SAMPLE BUREAU
KANSAS GEOLOGICAL SOCIETY BUILDING
508 EAST MURDOCK - WICHITA, KANSAS


COMPANY **Kaiser & Francis Oil & Gas, Inc.**
FARM **Hennessy** NO. **1**

SEC. **31** T. **8S** R. **18W**
LOC. **NE-NE SE**

TOTAL DEPTH **3512**
COMM. **11/12/55** COMP. **11/23/55**

COUNTY **Rooks**
KANSAS

SHOT OR TREATED
CONTRACTOR **H-30, Inc.**
ISSUED

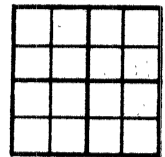

CASING
20 10
15 8 **208'**
12 6
13 5

ELEVATION **2061 K.B.**
PRODUCTION **D & A**

FIGURES INDICATE BOTTOM OF FORMATIONS

Surface Clay	50
Shale & Shells	435
Shale	595
Sand	640
Shale & Shells	955
Sand	1180
Shale, Shells & Red Bed	1450
Anhydrite	1495
Shale, Shells & Red Bed	1740
Shale & Lime	2000
Shale, Lime & Salt	2120
Shale & Lime	3175
Lime	3250
Shale & Lime	3290
Lime	3377
Shale & Lime	3415
Lime	3458
Lime, Shale & Chert	3504
Lime	3525

FORMATION TOPS

HEEBNER	3221
TORONTO	3241
LANSING	3258
CONGLOMERATE	3512

I hereby certify that this is a true and correct log of the above described well as shown by the drilling reports.

H-30, Inc.

By *PP Sproung*

STATE OF KANSAS |
COUNTY OF SEDGWICK | SS:

Subscribed and sworn to before me, a notary public, in and for said County and State this 25th day of November, 1955.

Rose Furey
Notary Public

My Commission expires February 13, 1956.

Dec 20, 1955

PLUGGING
WELL SEC 31 T 8 R 18W
BOOK PAGE 19 LINE 43