


STATE OF KANSAS
STATE CORPORATION COMMISSION

15-163-00973-00-00

Give All Information Completely
Make Required Affidavit
Mail or Deliver Report to:
Conservation Division
State Corporation Commission
211 No. Broadway
Wichita, Kansas

WELL PLUGGING RECORD

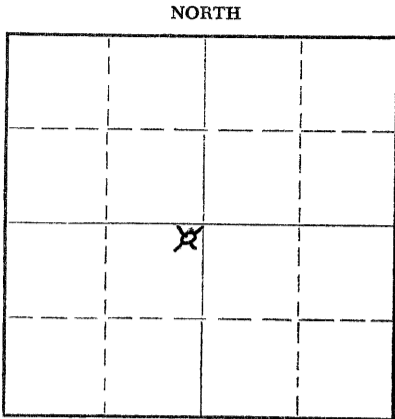

Locate well correctly on above
Section Plat

ROOKS County. Sec. 29 Twp. 8S Rge. 18W(E) (W)
Location as "NE/CNW%SW%" or footage from lines NE NE SW
Lease Owner Bankoff Oil Company & Leben Drilling, Inc.
Lease Name Mitchum No. 1 Well No. 1
Office Address 505 Orpheum Bldg, Wichita 2, Kansas
Character of Well (completed as Oil, Gas or Dry Hole) Dry Hole
Date well completed 4-22 19 56
Application for plugging filed 4-22 19 56
Application for plugging approved 4-22 19 56
Plugging commenced 4-22 19 56
Plugging completed 4-22 19 56
Reason for abandonment of well or producing formation Dry Hole

If a producing well is abandoned, date of last production _____ 19____
Was permission obtained from the Conservation Division or its agents before plugging was commenced? Yes

Name of Conservation Agent who supervised plugging of this well Eldon R. Petty
Producing formation _____ Depth to top _____ Bottom _____ Total Depth of Well 3530 Feet
Show depth and thickness of all water, oil and gas formations.

OIL, GAS OR WATER RECORDS

CASING RECORD

FORMATION	CONTENT	FROM	TO	SIZE	PUT IN	PULLED OUT
				8 5/8	201	

Describe in detail the manner in which the well was plugged, indicating where the mud fluid was placed and the method or methods used in introducing it into the hole. If cement or other plugs were used, state the character of same and depth placed, from _____ feet to _____ feet for each plug set.

Plugging: Rotary mud to 145 ft,
1/2 sk hulls, 15 sks cement; Mud
to 40 ft, 1/2 sk hulls, 10 sacks
cement to surface.

(If additional description is necessary, use BACK of this sheet)

Name of Plugging Contractor Leben Drilling, Inc.
Address 505 Orpheum Bldg, Wichita 2, Kansas

STATE OF KANSAS, COUNTY OF SEDGWICK, ss.
I, James M. Battin (employee of owner) or (~~owner~~) of the above-described well, being first duly sworn on oath, says: That I have knowledge of the facts, statements, and matters herein contained and the log of the above-described well as filed and that the same are true and correct. So help me God.

(Signature) James M. Battin
Wichita, Kansas
(Address)

SUBSCRIBED AND SWORN TO before me this 1st day of May, 19 56

My commission expires April 20, 1959

James D. Lison
Notary Public.

PLUGGING
FILE SEC 29 T 8 R 18W
BOOK PAGE 56 LINE 45

RECEIVED
STATE CORPORATION COMMISSION
MAY 22 1956
5-2-56
CONSERVATION DIVISION
Wichita, Kansas

15-103-00973-00-00

CONTRACTOR'S WELL LOG

COMPANY: Bankoff Oil Company and
 Contractor: Leben Drilling, Inc.
 FARM: Leben Drilling, Inc.
 LOCATION: Mitchum No. 1
 NE NE SW Sec. 29-8S-18W,
 Rooks County, Kansas
 COMMENCED: April 12, 1956
 COMPLETED: April 22, 1956

0	40	Surface Clay
40	195	Sand, Shale, Shells
195	202	Sand, Shale, Shells
202	450	Shale, Shells
450	945	Shale, Sand
945	1177	Sand
1177	1448	Shale
1448	1486	Anhydrite
1486	1641	Shale, Shells
1641	1950	Shale, Lime, Shells
1950	2127	Shale, Lime
2127	2173	Lime, Shale
2173	2304	Shale, Lime
2304	2942	Lime, Shale
2942	3057	Shale, Lime
3057	3204	Lime, Shale
3204	3226	Shale, Lime
3226	3283	Lime, Shale
3283	3435	Lime
3435	3450	Base Kansas City
3450	3480	Shale
3480	3497	Arbuckle
3497	3530	Cherty Lime
	<u>3530</u>	<u>Rotary Total Depth, D & A</u>

Set 201 feet of 8 5/8" Surface Casing with 175 sacks Cement.

I, James M. Battin, do hereby certify that the above and foregoing is a true and correct copy of the log of the Mitchum No. 1, NE NE SW Sec. 29-8S-18W, Rooks County, Kansas, as reflected by the files of Leben Drilling, Inc.

LEBEN DRILLING, INC.

BY: James M. Battin

STATE OF KANSAS)
COUNTY OF SEDGWICK) SS

Subscribed and sworn to before me, a Notary Public, in and for said County and State, this 1st day of May, 1956

Thomas D. Lison
Notary Public

My commission expires April 20, 1959.

52-56

PLUGGING
 FILE SEC. 29 T. 8 R. 18W
 BOOK PAGE 56 LINE 45