

15-163-20716-00-00


STATE OF KANSAS  
STATE CORPORATION COMMISSION

WELL PLUGGING RECORD

Give All Information Completely  
Make Required Affidavit  
Mail or Deliver Report to  
Conservation Division  
State Corporation Comm.  
245 North Water  
Wichita, KS 67202

Rocks \_\_\_\_\_ County. Sec. 29 Twp. 8 Rge. 18 NE/W  
Location as "NE/CNW 1/4 SW 1/4" or footage from lines NW NE SE

Lease Owner Graves Drilling Co., Inc.  
Lease Name Hinderson Well No. 1  
Office Address Box 910 Union Center, Wichita, Ks. 67202  
Character of Well (Completed as Oil, Gas or Dry Hole) Dry Hole  
Date Well completed July 11, 1977  
Application for plugging filed July 11 1977  
Application for plugging approved July 11 1977  
Plugging commenced July 11 1977  
Plugging completed July 11 1977  
Reason for abandonment of well or producing formation \_\_\_\_\_

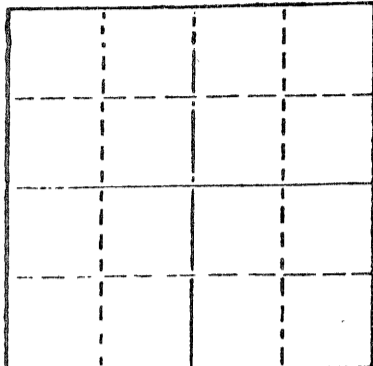

Locate well correctly on above  
Section Plat

If a producing well is abandoned, date of last production 19\_\_\_\_

Was permission obtained from the Conservation Division or its agents before plugging was commenced? yes

Name of Conservation Agent who supervised plugging of this well Leo Massey  
Producing formation \_\_\_\_\_ Depth to top \_\_\_\_\_ Bottom \_\_\_\_\_ Total Depth of Well 3519  
Show depth and thickness of all water, oil and gas formations.

OIL, GAS OR WATER RECORDS

CASING RECORD

FORMATION	CONTENT	FROM	TO	SIZE	PUT IN	PULLED OUT

Describe in detail the manner in which the well was plugged, indicating where the mud fluid was placed and the method or methods used in introducing it into the hold. If cement or other plugs were used, state the character of same and depth placed, from \_\_\_\_\_ feet to \_\_\_\_\_ feet for each plug set.

Hole full of heavy mud.  
Bottom Plug at 600' with 70 sacks cement thru d. p.  
Middle plug at 240' with 20 sacks cement thru d. p.  
Top plug at 40' and 10 sacks cement.

RECEIVED  
STATE CORPORATION COMMISSION

JUL 14 1977

CONSERVATION DIVISION  
Wichita, Kansas

17-14-77

(If additional description is necessary, use BACK of this sheet)

Name of Plugging Contractor Duke Drilling Co.

STATE OF Kansas COUNTY OF Barton, ss.  
Larry Curtis (employee of owner) or ~~(owner or operator)~~

of the above-described well, being first duly sworn on oath, says: That I have knowledge of the facts, statements, and matters herein contained and the log of the above-described well as filed and that the same are true and correct. So help me God.

(Signature) Larry Curtis  
Box 823 Great Bend, Ks. 67530  
(Address)

SUBSCRIBED AND SWORN TO before me this 12 day of July, 19 77

My commission expires April 11, 1978

Alberthy M. Nague  
Notary Public.

Drillers' Well Log

Date Commenced: July 5, 1977  
Date Completed: July 11, 1977

Graves Drilling Co.  
Hinderson #1  
NW NE SE  
Sec. 29-J85-R18N  
Rooks County, Ks.

Elevation: 2005 K.B.

- 0 - 243' Rock & Clay - Shale
- 243 - 685' Shale & Sand
- 685 - 920' Shale
- 920 - 1155' Sand
- 1155 - 1442' Red Bed
- 1442 - 1473' Anhydrite
- 1473 - 1615' Shale
- 1615 - 3158' Shale & Lime
- 3158 - 3162' Shale
- 3162 - 3202' Lime & Shale
- 3202 - 3419' Lime
- 3419 - 3519' Chert, Lime, Shale
- 3519' RJD

Formation Data	
Anhydrite	1442
Heebner	3158
Lansing	3202
Base K.C.	3419
RJD	3519

Surface Pipe: Set used 8-5/8" used pipe at 243' with 160 sacks common cement, 2% Gel, #3%cc.

A J J J D A V J J

State Of Kansas  
County of Barton & SS:

Larry Curtis of lawful age does swear and state that the facts and statements herein contained are true and correct to the best of his knowledge.

Larry Curtis  
Larry Curtis

Subscribed and sworn to before me this \_\_\_\_\_ day of July 1977.

My Comm. Expires: April 11, 1978

Noreen M. Sagne  
Notary Public