


Give All Information Completely
Make Required Affidavit
Mail or Deliver Report to:
Conservation Division
State Corporation Commission
211 No. Broadway
Wichita, Kansas

15-163-00806-00-00
WELL PLUGGING RECORD

NORTH

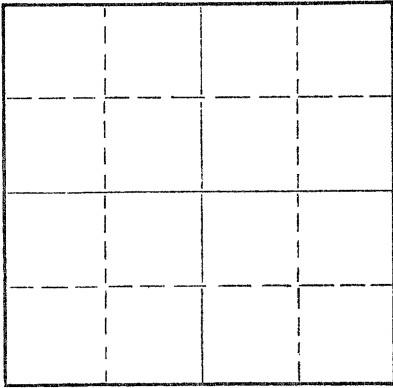

Locate well correctly on above
Section Plat

Rooks County. Sec. 30 Twp. 8 Rge. 18 (#) (W)
Location as "NE/CNW*SW*" or footage from lines SW-SW-SE
Lease Owner Woodman & Iannitti Drilling Company
Lease Name Hayes Well No. 1
Office Address 714 Union National Bldg. Wichita, Kansas
Character of Well (completed as Oil, Gas or Dry Hole) Dry Hole
Date well completed 8-10- 19 61
Application for plugging filed 8-10 19 61
Application for plugging approved 8-10 19 61
Plugging commenced 8-10 19 61
Plugging completed 8-10 19 61
Reason for abandonment of well or producing formation Dry

If a producing well is abandoned, date of last production _____ 19____
Was permission obtained from the Conservation Division or its agents before plugging was commenced? Yes

Name of Conservation Agent who supervised plugging of this well Eldon Petty
Producing formation _____ Depth to top _____ Bottom _____ Total Depth of Well 3600 Feet
Show depth and thickness of all water, oil and gas formations.

OIL, GAS OR WATER RECORDS

CASING RECORD

FORMATION	CONTENT	FROM	TO	SIZE	PUT IN	PULLED OUT
				8 5/8"	152	

Describe in detail the manner in which the well was plugged, indicating where the mud fluid was placed and the method or methods used in introducing it into the hole. If cement or other plugs were used, state the character of same and depth placed, from _____ feet to _____ feet for each plug set.

Bottom Plug at 540' with 20 sacks cement
Middle Plug at 152' with 20 sacks cement
Top Plug at 40' with 10 sacks cement

RECEIVED
STATE CORPORATION COMMISSION

AUG 15 1961

CONSERVATION DIVISION
Wichita, Kansas

(If additional description is necessary, use BACK of this sheet)
Name of Plugging Contractor Woodman & Iannitti Drilling Company 875-61
Address 714 Union National Building, Wichita, Kansas

STATE OF Kansas, COUNTY OF Sedgwick, ss.
K. T. Woodman (employee of owner) or (owner or operator) of the above-described well, being first duly sworn on oath, says: That I have knowledge of the facts, statements, and matters herein contained and the log of the above-described well as filed and that the same are true and correct. So help me God.

(Signature) K. T. Woodman

714 Union Natl. Bldg., Wichita, Ks.
(Address)

SUBSCRIBED AND SWORN TO before me this 14th day of August, 19 61

Mildred M. Page
Notary Public.

My commission expires My Commission Expires Sept. 21, 1961

MILDRED M. PAGE



DRILLING LOG

Company: Woodman & Iannitti Drilling Company
 Lease: #1 Hayes SW-SW-SE 30-8-18W
 Rooks County, Kansas
 Contractor: Woodman & Iannitti Drilling Company
 714 Union National Building
 Wichita, Kansas
 Date Commenced: 8-3-61
 Date Completed: 8-10-61
 Total Depth: 3600'
 Casing: 8 5/8" at 152' with 120 sacks of quick set cement.

Figures Indicate the Bottom of the Formation

0-130	Deep Post Sand	1470	Anhydrite
152	Blue Shale	1985	Shale & Shells
630	Shale	2075	Shale & Lime
930	Shale & Sand	3544	Lime
1115	Sand	3582	Conglomerate
1345	Red Bed & Shale	3600	Arbuckle
1435	Red Bed		

GEOLOGICAL TOPS

Elevation	2052	RB
Anhydrite	1428	4624
Heebner	3208	+1156
Toronto	3229	-1177
Lansing	3246	-1194
B/KC	3460	-1408
Cherty Conglomerate	3542	-1490
Arbuckle	3579	-1527
Total Depth	3600	-1548

I certify the above to be a true and correct copy of the Driller's Log and the Geological Tops to the best of my knowledge and belief.

WOODMAN & IANNITTI DRILLING COMPANY

X. T. Woodman

By: _____
 K. T. Woodman

RECEIVED
 STATE CORPORATION COMMISSION

AUG 15 1961
 CONSERVATION DIVISION
 Wichita, Kansas

8-15-61