


STATE OF KANSAS
STATE CORPORATION COMMISSION

WELL PLUGGING RECORD

Give All Information Completely
Make Required Affidavit
Mail or Deliver Report to:
Conservation Division
State Corporation Commission
800 Bittling Building
Wichita, Kansas

Rooks County, Sec. 32 Twp. 8 Rge. 18 ~~XX~~ (W)
Location as "NE/CNW $\frac{1}{4}$ SW $\frac{1}{4}$ " or footage from lines SW SW SW
Lease Owner The Derby Oil Company et al
Lease Name Hancock Well No. 1
Office Address Wichita, Kansas
Character of Well (completed as Oil, Gas or Dry Hole) Dry Hole
Date well completed February 25, 1950
Application for plugging filed February 25, 1950
Application for plugging approved March 1, 1950
Plugging commenced February 25, 1950
Plugging completed February 25, 1950
Reason for abandonment of well or producing formation Dry Hole

NORTH

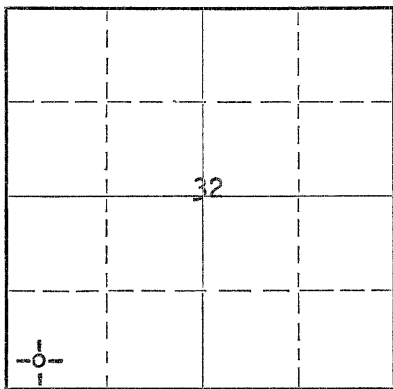

Locate well correctly on above Section Plat

If a producing well is abandoned, date of last production None 19
Was permission obtained from the Conservation Division or its agents before plugging was commenced? Yes

Name of Conservation Agent who supervised plugging of this well Mr. Eldon Petty
Producing formation None Depth to top --- Bottom --- Total Depth of Well 3530 Feet
Show depth and thickness of all water, oil and gas formations.

OIL, GAS OR WATER RECORDS

CASING RECORD

Formation	Content	From	To	Size	Put In	Pulled Out

Describe in detail the manner in which the well was plugged, indicating where the mud fluid was placed and the method or methods used in introducing it into the hole. If cement or other plugs were used, state the character of same and depth placed, from feet to feet for each plug set.

Heavy mud - 3530 - 209
Cement - 209 - 15 $\frac{1}{4}$
Heavy mud 15 $\frac{1}{4}$ - 35
Cement 35 - 6
Cellar 6 - 0

RECEIVED
Conservation Div.
MAR 11 1950
mar 11, 1950
STATE CORPORATION COMMISSION
KANSAS

(If additional description is necessary, use BACK of this sheet.)
Correspondence regarding this well should be addressed to The Derby Oil Company
Address 420 West Douglas, Wichita, Kansas

STATE OF Kansas, COUNTY OF Sedgwick, ss.
J. R. Bratcher (employee of owner) or (owner or operator) of the above-described well,
being first duly sworn on oath, says: That I have knowledge of the facts, and matters herein contained and the log of the above-described well as filed and that the same are true and correct. So help me God.

(Signature) J. R. Bratcher
Derby Oil Company, Wichita, Kansas.
(Address)

SUBSCRIBED AND SWORN to before me this 10th day of March, 1950.

H. A. Bilson, Notary Public.

My commission expires August 24, 1953

FILED MAR 30 8 18 AM
PAGE 140 LINE 29

1M-Grit

THE DERBY OIL COMPANY

Record of Well No. **1** Hancock Farm
 Location **SW SW SW** Sec. **32** Twp. **8** Rge. **18W**
 Contractor **John Lindas Oil, Inc.** County **Rooks**
 Drilling Commenced **February 7, 1950** State **Kansas**
 Elevation **2065 K.B.** Drilling Completed **February 25, 1950**

CASING RECORD

SIZE	FEET	KIND	WEIGHT	
8 5/8"	209	8 RT New J-55 ss	2 1/4	Cemented with 120 sacks cement.

FORMATION	BOTTOM	FORMATION	BOTTOM
Soil and shale	30	<u>GEOLOGICAL DATA</u> Top Lansing 3252 (-1187) No shows. Top Arbuckle 3508 (-1443) No shows.	
Sand	50		
Shale	209		
Shale & shells	475		
Shale	615		
Sand	670		
Shale & shells	1025		
Sand & shale	1185		
Shale, shells	1410		
Red bed	1455		
Anhydrite	1492		
Shale & shells	1900		
Salt & shale	1960		
Shale & broken lime	2040		
Shale & lime	2265		
Lime	2485		
Shale & shells	2580		
shale & lime	3120		
Lime	3160		
Lime & shale	3176		
Lime	3198		
Lime & shale	3240		
Lime	3530		
T. D.	3530		

RECEIVED
 MAR 11 1950
 STATE GEOLOGICAL SURVEY
 COMMISSION
 KANSAS

FILE SEC-32 T-8 R-180
 BOOK PAGE 140 LINE 29

DRILLING LOG

To: Derby Oil Company, et al.,
 420 West Douglas,
 Wichita 2, Kansas.

Lease: Hancock #1

County: Rooks, Kansas
 Section: 32-8-18
 Location: SW $\frac{1}{4}$ SW $\frac{1}{4}$ SW $\frac{1}{4}$

Rotary Total Depth: 3530'
 Commenced: 2-7-50 Completed: 2-25-50
 Casing: 8-5/8" @ 209' W/120 sacks cement & 1 sack calcium chloride
 5 1/2" @ none - dry

Contractor: John Lindas, Oil, Inc.,
 1316 Union National Bank Building,
 Wichita 2, Kansas.

FIGURES INDICATE BOTTOM OF FORMATIONS

0	to	30	Soil & Shale
30		50	Sand
50		209	Shale
209		475	Shale & Shells
475		615	Shale
615		670	Sand
670		1025	Shale & Shells
1025		1185	Sand & Shale
1185		1410	Shale, Shells & Red Bed
1410		1455	Red Bed
1455		1492	Anhydrite
1492		1900	Shale & Shells
1900		1960	Salt & Shale
1960		2040	Shale & Broken Lime
2040		2265	Shale & Lime
2265		2485	Lime
2485		2580	Shale & Shells
2580		3120	Shale & Lime
3120		3160	Lime
3160		3176	Lime & Shale
3176		3198	Lime
3198		3240	Lime & Shale
3240		3530	T.D. Lime

STATE OF KANSAS)
) ss
 COUNTY OF SEDGWICK)

I, the undersigned, being duly sworn on oath, state that the above statement and log is true and correct record and log of the well drilled at the location above described.

JOHN LINDAS OIL, INC.,

By Scott Stucky

Subscribed and sworn to before me this 8th day of March, 1950.

Catherine Dancy
 Notary Public

My Commission Expires March 25, 1952

Mar 09, 1950

PLUGGING
 FILE SEC 32-8-18
 BOOK PAGE 149 LINE 29