


All Information Completely
Required Affidavit
For Deliver Report to:
Conservation Division
State Corporation Commission
211 No. Broadway
Wichita, Kansas

WELL PLUGGING RECORD

NORTH

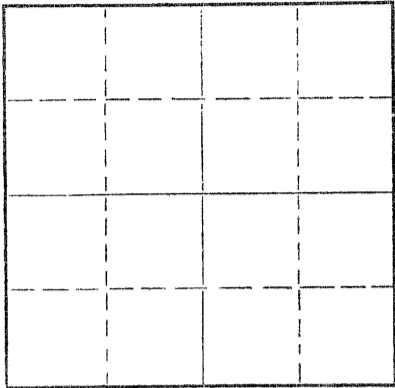

Locate well correctly on above
Section Plat

Rooks County. Sec. 31 Twp. 8S Rge. 18W (E~~X~~) (W)
Location as "NE CNW~~SW~~" or footage from lines SW SE SE
Lease Owner. Hinkle Oil Company
Lease Name Beringer Well No. 1
Office Address 1016 Union Center, Wichita, Kansas
Character of Well (completed as Oil, Gas or Dry Hole) Dry Hole
Date well completed 7-10-63 19
Application for plugging filed 7-10-63 19
Application for plugging approved 7-10-63 19
Plugging commenced 7-10-63 19
Plugging completed 7-10-63 19
Reason for abandonment of well or producing formation Dry Hole

If a producing well is abandoned, date of last production 19
Was permission obtained from the Conservation Division or its agents before plugging was com-
menced? yes

Name of Conservation Agent who supervised plugging of this well Eldon Petty, Hays, Kansas
Producing formation _____ Depth to top _____ Bottom _____ Total Depth of Well 3500 Feet
Show depth and thickness of all water, oil and gas formations.

OIL, GAS OR WATER RECORDS

CASING RECORD

FORMATION	CONTENT	FROM	TO	SIZE	PUT IN	PULLED OUT
				8 5/8"	212'	none

Describe in detail the manner in which the well was plugged, indicating where the mud fluid was placed and the method or methods used in introducing it into the hole. If cement or other plugs were used, state the character of same and depth placed, from _____ feet to _____ feet for each plug set.

1st plug @ 550', 20 sacks cement

2nd plug, 200', 20 sacks cement

Top Plug @ 35', 1/2 sk. hulls, 10 sacks to bottom cellar

RECEIVED
STATE CORPORATION COMMISSION

JUL 15 1963

JUL 15 1963
CONSERVATION DIVISION
Wichita, Kansas

(If additional description is necessary, use BACK of this sheet)

Name of Plugging Contractor Leben Drilling, Inc.
Address P. O. Box 486, Great Bend, Kansas

STATE OF KANSAS, COUNTY OF BARTON, ss.
Leslie Kite

(employee of owner) or (owner or operator) of the above-described well, being first duly sworn on oath, says: That I have knowledge of the facts, statements, and matters herein contained and the log of the above-described well as filed and that the same are true and correct. So help me God.

(Signature) Leslie Kite

P. O. Box 486, Great Bend, Kansas
(Address)

SUBSCRIBED AND SWORN TO before me this 12th day of July, 1963

My commission expires April 1, 1967

Ulanda Nichols
Notary Public.



DRILLER'S LOG

COMPANY: Hinkle Oil Company
 CONTRACTOR: LEBEN DRILLING, INC.
 FARM: BERINGER #1
 LOCATION: SW SE SE Sec. 31-8S-18W
 ROOKS COUNTY, KANSAS
 COMMENCED: 7-3-63
 COMPLETED: 7-10-63

0	70	Surface Soil & Post Rock
70	212	Sand, Shale, Shells
212	930	Shale
930	1170	Sand
1170	1439	Redbed
1439	1479	Anhydrite
1479	1830	Shale, Shells
1830	3235	Lime, Shale
3235	3500	Lime
	<u>3500</u>	<u>Rotary Total Depth - D. & A.</u>

Set 8 5/8" used surface casing @ 212' Cemented with 175 sacks HAS Posmix.

I, Leslie Kite, do hereby certify that the above and foregoing is a true and correct copy of the log of the Beringer #1, located SW SE SE of Section 31, Township 8 South, Range 18 West, Rooks County, Kansas, as reflected by the files of Leben Drilling, Inc.

Leslie Kite

Leslie Kite

STATE OF KANSAS)
) SS
 COUNTY OF BARTON)

Subscribed and sworn to before me, a Notary Public, in and for Barton County, Kansas, this 12th day of July, 1963.

Ulanda Nichols

Ulanda Nichols, Notary Public

My Commission Expires:
 April 1, 1967

RECEIVED
 STATE CORPORATION COMMISSION
 JUL 15 1963
 JUL 15, 1963
 CONSERVATION DIVISION
 Wichita, Kansas