


STATE OF KANSAS
STATE CORPORATION COMMISSION

Give All Information Completely
Make Required Affidavit
Mail or Deliver Report to:
Conservation Division
State Corporation Commission
212 North Market, Insurance Bldg.
Wichita, Kansas

WELL PLUGGING RECORD

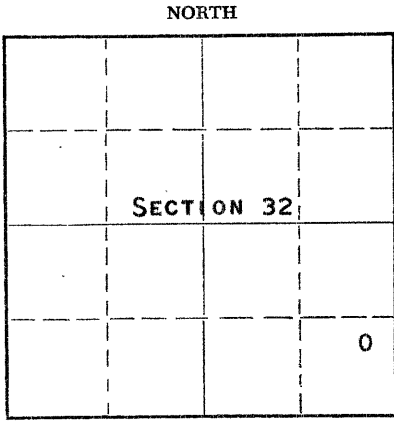

Locate well correctly on above
Section Plat

ROOKS County. Sec. 32 Twp. 8S Rge. 18W (#) (W)
Location as "NE/CNW%SW%" or footage from lines SW NE SE
Lease Owner PETROLEUM, INC.
Lease Name THOMPSON "A" Well No. 2
Office Address ROUTE 2, GREAT BEND, KANSAS
Character of Well (completed as Oil, Gas or Dry Hole) DRY HOLE
Date well completed NOVEMBER 13 19 59
Application for plugging filed NOVEMBER 13 19 59
Application for plugging approved NOVEMBER 13 19 59
Plugging commenced NOVEMBER 13 19 59
Plugging completed NOVEMBER 13 19 59
Reason for abandonment of well or producing formation NO PRODUCIBLE ZONES

If a producing well is abandoned, date of last production NONE 19
Was permission obtained from the Conservation Division or its agents before plugging was commenced? YES

Name of Conservation Agent who supervised plugging of this well ELDON PETTY, BOX 326, HAYS, KANSAS
Producing formation ----- Depth to top ----- Bottom ----- Total Depth of Well 3508 Feet
Show depth and thickness of all water, oil and gas formations.

OIL, GAS OR WATER RECORDS

CASING RECORD

FORMATION	CONTENT	FROM	TO	SIZE	PUT IN	PULLED OUT
				8-5/8"	206'	NONE

Describe in detail the manner in which the well was plugged, indicating where the mud fluid was placed and the method or methods used in introducing it into the hole. If cement or other plugs were used, state the character of same and depth placed, from _____ feet to _____ feet for each plug set.

MUD UP WITH HEAVY MUD TO 500', PUSHED DOWN 1/4 SACK HULLS TO 500' FOLLOWED BY WOODEN PLUG. PLACED 20 SACKS CEMENT THROUGH DRILL PIPE ON TO PLUG. MUD UP WITH HEAVY MUD TO 40' AND PLACED 1/4 SACK HULLS AT 40' FOLLOWED BY WOODEN PLUG AND 10 SACKS CEMENT

RECEIVED
STATE CORPORATION COMMISSION
DEC 10 1959
DEC 10 1959
CONSERVATION DIVISION
Wichita, Kansas

(If additional description is necessary, use BACK of this sheet)

Name of Plugging Contractor GARVEY DRILLING COMPANY
Address ROUTE 2, GREAT BEND, KANSAS

STATE OF KANSAS, COUNTY OF BARTON, ss.
DON SEARLE (employee of owner) or (owner) of the above-described well, being first duly sworn on oath, says: That I have knowledge of the facts, statements, and matters herein contained and the log of the above-described well as filed and that the same are true and correct. So help me God.

(Signature) Don Searle
ROUTE 2, GREAT BEND, KANSAS (Address)

SUBSCRIBED AND SWORN TO before me this 8TH day of DECEMBER, 19 59

Arthur J. Wiles
Notary Public.

My commission expires APRIL 14, 1963



WELL LOG

COMPANY, PETROLEUM, INCORPORATED

SEC. 32 T. 8S R. 18W

FARM THOMPSON "A" NO. 2


LOC. SW, NE, SE

TOTAL DEPTH 3508'

COUNTY ROOKS CO., KANSAS

COMM. November 4, 1959 COMP. November 13, 1959

CONTRACTOR GARVEY DRILLING COMPANY

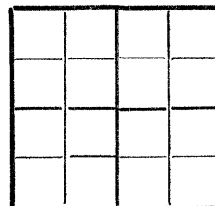

CASING 8 5/8" @ 206' W/150 sax.

ELEVATION 2046' DF

PRODUCTION D & A

FIGURES INDICATE BOTTOM OF FORMATIONS

180	Shale & shells
280	Shale
850	Shale & shells
1010	Sand
1180	Shale
1452	Red bed
1488	Anhydrite
2120	Shale
2290	Lime
2805	Lime & shale
3010	Shale
3075	Lime & shale
3470	Lime
3489	Lime & shale
3508	Lime
3508	T. D.

RECEIVED
 STATE CORPORATION COMMISSION
 DEC 10 1959
 DEC 10 1959
 CONSERVATION DIVISION
 Wichita, Kansas

State of KANSAS }
 County of BARTON } ss:

I, VERNE A. MORRIS of GARVEY DRILLING COMPANY

upon oath state that the above and foregoing is a true and correct copy of the log of the #2 THOMPSON "A" well.

Verne A. Morris

Subscribed and sworn to before me this 4th day of December 19 59

My Commission Expires: April 14, 1963

Arthur J. Wiles
 NOTARY PUBLIC