


STATE OF KANSAS
STATE CORPORATION COMMISSION

Give All Information Completely
Make Required Affidavit
Mail or Deliver Report to:
Conservation Division
State Corporation Commission
800 Bitting Building
Wichita, Kansas

WELL PLUGGING RECORD

NORTH

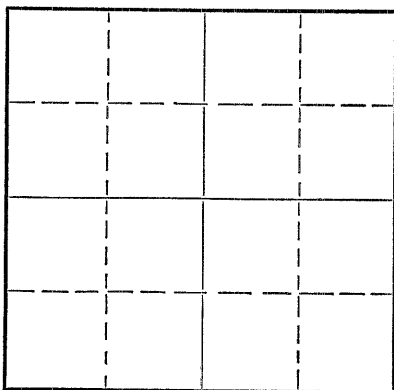

Locate well correctly on above
Section Plat

Rooks County. Sec. 32 Twp. 8 Rge. (E) 18 (W)
Location as "NE/CNW $\frac{1}{4}$ SW $\frac{1}{4}$ " or footage from lines NE NE SE
Lease Owner Harry Gore
Lease Name Garmichael Well No. 1
Office Address 400 Brown Bldg., Wichita, Ks.
Character of Well (completed as Oil, Gas or Dry Hole) dry hole
Date well completed 10-5-50
Application for plugging filed 10-25-50
Application for plugging approved 10-25-50
Plugging commenced 10-25-50
Plugging completed 10-29-50
Reason for abandonment of well or producing formation dry hole
If a producing well is abandoned, date of last production 19
Was permission obtained from the Conservation Division or its agents before plugging was commenced? yes

Name of Conservation Agent who supervised plugging of this well Eldon Petty
Producing formation Depth to top Bottom Total Depth of Well 3510 Feet
Show depth and thickness of all water, oil and gas formations.

OIL, GAS OR WATER RECORDS

CASING RECORD

Formation	Content	From	To	Size	Put In	Pulled Out
				5 $\frac{1}{2}$ "	3455'	2954'

Describe in detail the manner in which the well was plugged, indicating where the mud fluid was placed and the method or methods used in introducing it into the hole. If cement or other plugs were used, state the character of same and depth placed, from feet to feet for each plug set.

3510 to 3450'	Filled with sand.
3450 to 3420'	Five sax cement.
3420 to 175'	Mudded.
175 to 160'	Rock bridge
160 to 120'	15 sax cement
120 to 30'	Mud
30' to cellar	10 sax cement.

RECEIVED
STATE CORPORATION COMMISSION
NOV 7 - 1950
NOV 7 - 1950
CONSERVATION DIVISION
Wichita, Kansas

(If additional description is necessary, use BACK of this sheet)
Correspondence regarding this well should be addressed to Harry Gore, 400 Brown Bldg., Wichita, Ks.
Address

STATE OF Kansas, COUNTY OF Sedgwick, ss.
Ralph Gore (employee of owner) or (owner or operator) of the above-described well,
being first duly sworn on oath, says: That I have knowledge of the facts, statements and matters herein contained and the log of the above-described well as filed and that the same are true and correct. So help me God.
(Signature) Ralph Gore
Partner
400 Brown Bldg., Wichita, Ks.
(Address)

SUBSCRIBED AND SWORN TO before me this 6th day of November, 1950.

My commission expires June 7, 1952 Notary Public.

28-5091-s 8-50-10M
PLUGGING
FILE SEC. 32 T. 8 R. 18 W
BOOK PAGE 38 LINE 13

WELL LOG BUREAU -- KANSAS GEOLOGICAL SOCIETY
508 East Murdock, Wichita, Kansas

15-163-19139-00-00

Company - HARRY GORE
Farm - Carmichael No. 1

SEC. 32 T. 8 R. 18W
NE NE SE

Total Depth. 3510
Comm. 9-20-50 Comp. 10-5-50
Shot or Treated. Acidized.
Contractor. B & R Drlg.
Issued. 10-28-50

County. Rooks
KANSAS



CASING:
8 5/8" 177' cem w/125 sx.
5 1/2" 3455 1/2" cem w/100 sx.

Elevation. 2030 RB
2038
Production. 2021 GA
dry

Figures Indicate Bottom of Formations.

shale, lime	41
shale, shells	177
shale	190
shale, shells	460
shale, sand	600
shale, shells	760
sand	830
shale, shells, sand	850
shale	927
sand	1080
shale	1090
sand	1150
shale, shells	1355
red bed, sand, shale	1380
red bed, shale	1418
anhydrite	1454
shale, shells	1875
shale, lime	2175
lime	2320
shale, lime	3105
lime	3140
lime, shale	3190
lime	3455
shale, lime	3460
lime, arbuckle	3467
lime	3510
Total Depth	

Tops:

Heebner Shale	3164
Lansing-K.C.	3202
Conglomerate	3449
Arbuckle	3455

RECEIVED
CORPORATION COMMISSION

NOV 7 1950

PLUGGING
FILE SEC-32 T-8 R-18W
BOOK PAGE 38 LINE 12