


STATE OF KANSAS  
STATE CORPORATION COMMISSION

Give All Information Completely  
Make Required Affidavit  
Mail or Deliver Report to:  
Conservation Division  
State Corporation Commission  
800 Bittling Building  
Wichita, Kansas

WELL PLUGGING RECORD

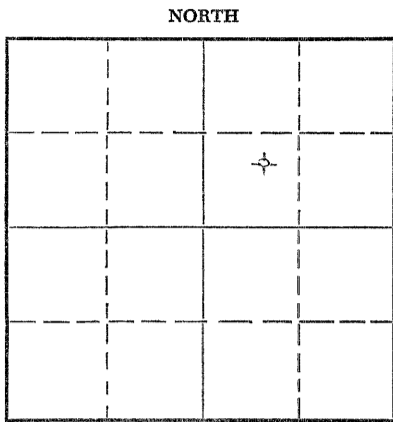

Locate well correctly on above  
Section Plat

Rooks County. Sec. 33 Twp. 8S Rge. 18 (E) W (W)  
Location as "NE/CNW/SW" or footage from lines NE/4 SW/4 NE/4  
Lease Owner Manhart, Millison & Beebe  
Lease Name Bolton Well No. 1  
Office Address 503 Jenkins Bldg., Tulsa 3, Oklahoma  
Character of Well (completed as Oil, Gas or Dry Hole) Dry Hole  
Date well completed September 27, 1953  
Application for plugging filed (Verbal) September 27, 1953  
Application for plugging approved (Verbal) September 27, 1953  
Plugging commenced September 27, 1953  
Plugging completed September 27, 1953  
Reason for abandonment of well or producing formation Dry Hole

If a producing well is abandoned, date of last production \_\_\_\_\_ 19\_\_\_\_  
Was permission obtained from the Conservation Division or its agents before plugging was commenced? Yes

Name of Conservation Agent who supervised plugging of this well Eldon Petty  
Producing formation \_\_\_\_\_ Depth to top \_\_\_\_\_ Bottom \_\_\_\_\_ Total Depth of Well 3465 Feet  
Show depth and thickness of all water, oil and gas formations.

OIL, GAS OR WATER RECORDS

CASING RECORD

| FORMATION | CONTENT | FROM | TO   | SIZE   | PUT IN | PULLED OUT |
|-----------|---------|------|------|--------|--------|------------|
|           |         | 0    | 150' | 8-5/8" | 150'   | none       |
|           |         |      |      |        |        |            |
|           |         |      |      |        |        |            |
Describe in detail the manner in which the well was plugged, indicating where the mud fluid was placed and the method or methods used in introducing it into the hole. If cement or other plugs were used, state the character of same and depth placed, from \_\_\_\_\_ feet to \_\_\_\_\_ feet for each plug set.

Bottom plug set at 145'. 15 sacks cement.  
Top plug set at 40'. 10 sacks cement.

OCT-7-1953


(If additional description is necessary, use BACK of this sheet)  
Name of Plugging Contractor Birmingham-Bartlett Drilling Co.  
Address 300 Kaufman Bldg., Wichita 2, Kansas

STATE OF Kansas COUNTY OF Sedgwick  
Richard Hindery, partner of Birmingham-Bartlett Drilling Co., Contractor for  
well, being first duly sworn on oath, says: That I have knowledge of the facts, statements, and matters herein contained and the log of the above-described well as filed and that the same are true and correct. So help me God. BIRMINGHAM-BARTLETT DRILLING CO.  
(Signature) BY Richard Hindery Partner  
300 Kaufman Bldg., Wichita 2, Kansas (Address)

SUBSCRIBED AND SWORN TO before me this 29th day of September, 19 53

My commission expires October 2, 1954

Beverly Larson  
Notary Public.

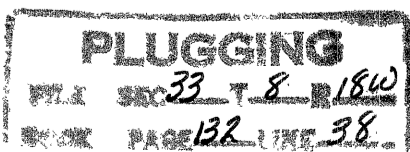

BOLTON NO. 1 WELL

LOCATION: NE/4 SW/4 NE/4  
Section 33-8S-18W  
Rooks County, Kansas

SPUDED: 9-17-53  
COMPLETED: 9-27-53

OWNER: Manhart, Millison & Beebe  
503 Jenkins Building  
Tulsa 3, Oklahoma

CONTRACTOR: Birmingham-Bartlett Drilling Co.  
300 Kaufman Building  
Wichita 2, Kansas

SURFACE CASING: 8 5/8" casing cemented at 150'  
with 100 sacks and 1 cc.

OIL STRING: None set. Dry and Abandoned.

LOG

(Figures indicate bottom of formation)

|     |      |                        |
|-----|------|------------------------|
| 0 - | 60   | Surface and rock       |
|     | 149  | Shale and shells       |
|     | 1160 | Shale, sand and shells |
|     | 1380 | Red bed and shells     |
|     | 1420 | Anhydrite              |
|     | 1900 | Shale and shells       |
|     | 2930 | Lime and shale         |
|     | 3330 | Lime                   |
|     | 3422 | Lime and shale         |
|     | 3439 | Shale                  |
|     | 3465 | Arbuckle               |
|     | 3465 | Total Depth D & A      |

The undersigned, Richard Hindery, one of the partners of Birmingham-Bartlett Drilling Co., hereby certifies that the above is a true and correct log of the formations encountered in drilling the Bolton No. 1 Well as shown in the daily drilling reports.

BIRMINGHAM-BARTLETT DRILLING CO.

By Richard Hindery

Subscribed and sworn to before me  
this 29th day of September, 1953.

OCT 7 1953

Beverly Larson  
Notary Public

My commission expires October 2, 1954

