

STATE OF KANSAS
STATE CORPORATION COMMISSION


Form CP-6

WELL PLUGGING RECORD

Give All Information Completely
Make Required Affidavit
Mail or Deliver Report to:
Conservation Division
State Corporation Commission
P. O. Box 17027
Wichita, Kansas 67217
NORTH

Rooks County, Sec. 33 Twp. 8 Rge. (E) 18 (W)

Location as "NE/CNWSW" or footage from lines SE NW SW
Lease Owner Petroleum, Inc.
Lease Name Carmichael L-KC Well No. 1-2
Office Address RR #2, Great Bend, Kansas 67530
Character of Well (completed as Oil, Gas or Dry Hole) oil
Date well completed 19
Application for plugging filed 19
Application for plugging approved 19
Plugging commenced April 25 1974
Plugging completed May 8 1974
Reason for abandonment of well or producing formation depleted

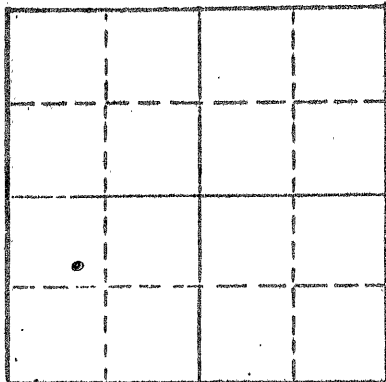

Locate well correctly on above Section Plot

If a producing well is abandoned, date of last production 19
Was permission obtained from the Conservation Division or its agents before plugging was commenced? YES

Name of Conservation Agent who supervised plugging of this well Leo F. Massey
Producing formation Depth to top Bottom Total Depth of Well 3468 Feet
Show depth and thickness of all water, oil and gas formations.

OIL, GAS OR WATER RECORDS

CASING RECORD

FORMATION	CONTENT	FROM	TO	SIZE	PUT IN	PULLED OUT
		0	201'	8 5/8"	201'	none
			3466'	5 1/2"	3466'	695.00

Describe in detail the manner in which the well was plugged, indicating where the mud fluid was placed and the method or methods used in introducing it into the hole. If cement or other plugs were used, state the character of same and depth placed, from feet to feet for each plug set.

Sanded back to 3000' and dumped 4 sacks of cement.

Plugged well with 3 sacks of hulls, 25 sacks of mud and 100 sacks of cement.

(If additional description is necessary, use BACK of this sheet)
Name of Plugging Contractor PIPE PULLERS, INC.
Address Box 486, Ellinwood, Kansas 67526

STATE OF KANSAS COUNTY OF BARTON, ss.
Evelyn Roth

(employee of owner) or (owner or operator) of the above-described well, being first duly sworn on oath, says: That I have knowledge of the facts, statements, and matters herein contained and the log of the above-described well as filed and that the same are true and correct. So help me God.

(Signature) Evelyn Roth
Ellinwood, Kansas

SUBSCRIBED AND SWORN to before me this 13th day of May, 1974

My commission expires Feb. 10, 1975
Serge A. Meyer Notary Public.

Received: May 17th, 1974

WELL LOG BUREAU--KANSAS GEOLOGICAL SOCIETY
508 East Murdock, Wichita, Kansas


Company- PETROLEUM, INC.
Farm- Carmichael-Moshe No. No. 2

SEC. 33 SE NW SW 8 R. 18W

Total Depth. 3468
Comm. 4-26-55 Comp. 5-6-55
Shot or Treated.
Contractor. Garvey Drilling Co.
issued. 8-20-55

County, Rooks

KANSAS

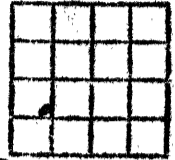

Elevation. 2017 KB

Production. 45 BOPD

CASING:
8 5/8 @ 201' w/ 135 sx cmt.
4 1/2 @ 3451' w/ 75 sx cmt.

Figures indicate Bottom of Formations.

shale & shells	730
shale, sand & shells	1390
anhydrite	1423
shale & shells	1930
lime	2015
lime & shale	2695
shale & shells	2835
shale	2965
shale & lime	3040
lime	3100
lime & shale	3160
lime	3370
lime & shale	3405
lime	3468
Total Depth	

TOPS:	
Topeka	2939
Heebner	3146
Toronto	3167
Lansing	3189
Conglomerate	3439
Arbuckle	3450

RECEIVED
STATE CORPORATION COMMISSION
MAY 17 1974
may 17 1974
CONSERVATION DIVISION
Wichita, Kansas