

15-163-22163-00-00


STATE OF KANSAS
STATE CORPORATION COMMISSION
200 Colorado Derby Bldg.
Wichita, Kansas 67202

Form CP-4
Rev. 12-15-8

WELL PLUGGING RECORD

Give All Information Completely
Make Required Affidavit

COUNTY Rooks SEC. 33 TWP. 8S RGE. 18W E/
Location as in quarters or footage from lines:
990' from North line & 2310' from West line

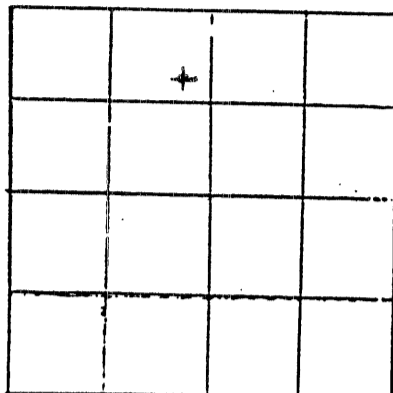

Locate Well
correctly on above
Section Platt.

Lease Owner Southern States Oil Company
Lease Name Finnesy "A" Well No. 2
Office Address P.O. Box 1365, Great Bend, Ks. 67530
Character of Well (Completed as Oil, Gas or Dry Hole): D/A
Date Well Completed 9-28-83
Application for plugging filed 9-28-83
Plugging commenced 9-28-83
Plugging completed 9-28-83
Reason for abandonment of well or producing formation D/A

Was permission obtained from the Conservation Division or it's
Agent's before plugging was commenced? yes

Name of Conservation Agent who supervised plugging of this well Schumaker
Producing formation _____ Depth to top _____ bottom _____ T.D. 3500'

Show depth and thickness of all water, oil and gas formations.

OIL, GAS OR WATER RECORDS

Casing Record

Formation	Content	From	To	Size	Put in	Pulled Out
				8 5/8"	249.94'	-0-

Describe in detail the manner in which the well was plugged, indicating where the mud
fluid was placed and the method or methods used in introducing it into the hold. If cemen
or other plugs were used, state the character of same and depth placed, from _____ fee
to _____ feet for each plug set.

1st plug set @ 1435' w/20 sacks cement
2nd plug set @ 905' w/100 sacks cement
3rd plug set @ 308' w/40 sacks cement
Bridge plug set @ 40' w/10 sacks
Rathole w/10 sacks
cement was 50/50 pozmix, 6% gel, 3% cc


RECEIVED
STATE CORPORATION COMMISSION
OCT 13 1983
CONSERVATION DIVISION
Wichita, Kansas

(If additional description is necessary, use BACK of this sheet)

Name of Plugging Contractor Sun Oil Well Cementing

STATE OF Kansas COUNTY OF Barton, ss.
Claude Blakesley (employee of owner) or (owner or operator) of the
above-described well, being first duly sworn on oath, says: That I have knowledge of the
facts, statements, and matters herein contained and the log of the above-described well as
filed and that the same are true and correct. So help me God.

(Signature) Claude Blakesley
P.O. Box 1365, Great Bend, Ks.
(Address)

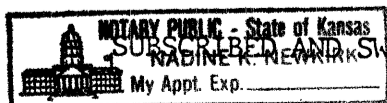

SUBSCRIBED AND SWORN TO before me this 7th day of October, 19 83

Nadine R. Newkirk
Notary Public.

My Commission expires: June 24, 1985