


STATE OF KANSAS
STATE CORPORATION COMMISSION

Give All Information Completely
Make Required Affidavit
Mail or Deliver Report to:
Conservation Division
State Corporation Commission
211 No. Broadway
Wichita, Kansas

WELL PLUGGING RECORD

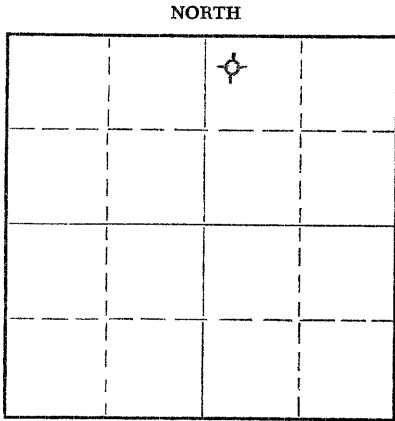

Locate well correctly on above
Section Plat

Rooks County. Sec. 34 Twp. 8 Rge. 18W (E) (W)
Location as "NE/CNW/SW" or footage from lines NW NW NE
Lease Owner Findeiss, et al
Lease Name Harris Well No. 1
Office Address Stockton, Kansas
Character of Well (completed as Oil, Gas or Dry Hole) Dry Hole
Date well completed March 22 19 57
Application for plugging filed March 22 19 57
Application for plugging approved March 22 19 57
Plugging commenced March 22 19 57
Plugging completed March 22 19 57
Reason for abandonment of well or producing formation Too low structurally

If a producing well is abandoned, date of last production 19
Was permission obtained from the Conservation Division or its agents before plugging was commenced? Yes

Name of Conservation Agent who supervised plugging of this well Eldon Petty, Hays, Kansas
Producing formation _____ Depth to top _____ Bottom _____ Total Depth of Well 8450 Feet
Show depth and thickness of all water, oil and gas formations.

OIL, GAS OR WATER RECORDS

CASING RECORD

FORMATION	CONTENT	FROM	TO	SIZE	PUT IN	PULLED OUT
				8-5/8"	183'	none

Describe in detail the manner in which the well was plugged, indicating where the mud fluid was placed and the method or methods used in introducing it into the hole. If cement or other plugs were used, state the character of same and depth placed, from _____ feet to _____ feet for each plug set.

Filled hole with heavy mud to 178'. Set plug. Put in 1/2 sack Hulls & 15 sacks cement
Filled with heavy mud to 40'. Set plug. Filled to top with 1/2 sack Hulls and 15 sacks cement.

RECEIVED
STATE CORPORATION COMMISSION

MAR 29 1957
MAY 29 1957
CONSERVATION DIVISION
Wichita, Kansas

(If additional description is necessary, use BACK of this sheet)

Name of Plugging Contractor C-G Drilling Co.
Address 107 Rule Building, Wichita, Kansas


STATE OF KANSAS, COUNTY OF SEDGWICK, ss.
Jay H. Galloway (employee of owner) or (owner or operator) of the above-described well, being first duly sworn on oath, says: That I have knowledge of the facts, statements, and matters herein contained and the log of the above-described well as filed and that the same are true and correct. So help me God.

(Signature) Jay H. Galloway
107 Rule Building
(Address)

SUBSCRIBED AND SWORN to before me this 26th day of March, 1957

My commission expires May 20, 1959

Vicky Jacobs
Vicky Jacobs Notary Public.

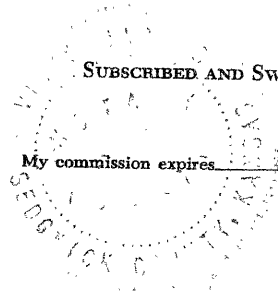

PLUGGING
SEC. 34 T. 8 R. 18W
BOOK PAGE 2 LINE 6

CONTRACTOR'S WELL LOG

OPERATOR Findeiss, et al WELL NAME Harris #1
 LOCATION NW NW NE 34-8-18W RIG NO. 2
 COUNTY Rooks STATE Kansas
 COMMENCEMENT DATE March 12, 1957 COMPLETION DATE March 21, 1957

LOG OF WELL

Elevation 1992' rotary bushing
 All measurements taken from the top of rotary bushing.

FROM	TO	FORMATION	DEVIATION FROM VERTICAL	REMARKS:
0	183	Shale-Sand		
183	510	Shale		
510	645	Sand		
645	1095	Shale-Sand		
1095	1341	Red Bed		
1341	1386	Anhydrite		
1386	1600	Shale-Shells		
1600	1875	Shale-Shells		
1875	1900	Shale-Lime		
1900	2190	Shale-Lime		
2190	2325	Shale-Lime		
2325	2545	Shale-Lime	0° - 2500	
2545	2780	Shale-Lime	0° - 2750	
2780	2985	Shale-Lime		
2985	3107	Lime-Shale	0° - 3000	
3107	3226	Lime		DST 3150 - 3200
3226	3362	Lime	0° - 3250	DST 3239 - 3260
3362	3450	Lime		DST 3430 - 3436

CASING LEFT IN HOLE AFTER COMPLETION

Ran 183' (9 jts.) 8-5/8" OD Surface Casing

STATE OF KANSAS }
 COUNTY OF SEDGWICK } ss.

The undersigned hereby certifies that to the best of his knowledge and belief, the above facts are true and correct.

C-G DRILLING CO.
 By Jay H. Galloway
 Jay H. Galloway

Subscribed and sworn to before me this 26th day of March, 1957.

Vicky Jacobs
 Vicky Jacobs, Notary Public

My commission expires: May 20, 1959.

RECEIVED
 STATE COMMISSION
 MAR 29 1957

PLUGGING
 FILE SEC. 34 T. 8. R. 18W
 BOOK PAGE 2 LINE 6

ION DIVISION
 Kansas