

15-163-03865-00-00

DISTRICT CONSERVATION AGENT'S REPORT

TO:

State Corporation Commission  
Conservation Division  
800 Bitting Building  
Wichita, Kansas

FILE NO. 9-25

LOCATION C. NW. SW

SEC. 31 TWP. 8S RGE. 17W

Dry Hole        Abandoned Oil Well yes Abandoned Gas Well       

I have today completed supervision of plugging of:

Well No. 2 Lease Doputa


Operator Phillips Oil Co. Address St. Wend. Kans

Field        County Rooks

Total Depth 3429 Feet.

(Describe briefly the manner in which the well was plugged)

*The hole was cemented 3429 to 3400 ft  
20-22 coarse sand, heavy mud 3400 to bridge  
of rock & narrow d. at 210 ft cement 210 ft  
to 150 ft 20-22 coarse sand 150 ft to 122 ft cement  
into Wilson Pass, 10-20 ft*

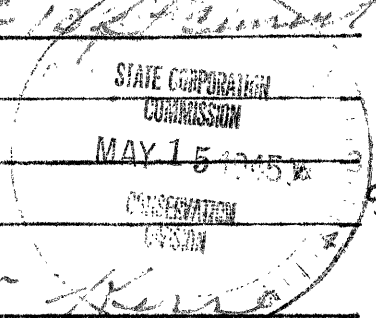

5/15/45

A. W. Kerne  
District Conservation Agent

Date May 13-45

31 8.17W  
9 25