

15-103-20088-00-00


STATE OF KANSAS  
STATE CORPORATION COMMISSION

Give All Information Completely  
Make Required Affidavit  
Mail or Deliver Report to:  
Conservation Division  
State Corporation Commission  
212 No. Market  
Wichita, Kansas

WELL PLUGGING RECORD

Rooks County, Sec. 26 Twp. 8 Rge. 18 (E)W (W)  
C/2 NW SW

Location as "NE/CNW/SW" or footage from lines  
Lease Owner Clinton Oil Company  
Lease Name Kriley #1 Well No. \_\_\_\_\_  
Office Address Wichita, Kansas  
Character of Well (completed as Oil, Gas or Dry Hole) oil  
Date well completed Jan. 12, 1968 19\_\_\_\_  
Application for plugging filed December 27 19 68  
Application for plugging approved December 30 19 68  
Plugging commenced 1/3/69 19\_\_\_\_  
Plugging completed 1/8/69 19\_\_\_\_  
Reason for abandonment of well or producing formation dry hole

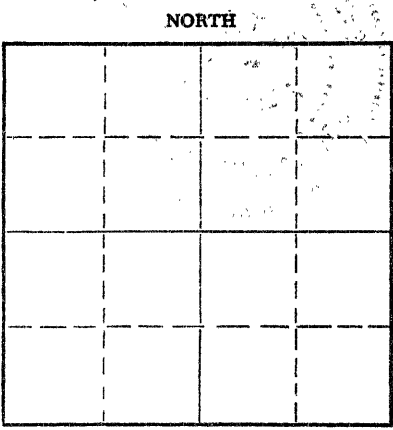

Locate well correctly on above  
Section Plat

If a producing well is abandoned, date of last production \_\_\_\_\_ 19\_\_\_\_  
Was permission obtained from the Conservation Division or its agents before plugging was commenced? yes

Name of Conservation Agent who supervised plugging of this well Massey  
Producing formation \_\_\_\_\_ Depth to top \_\_\_\_\_ Bottom \_\_\_\_\_ Total Depth of Well 3516 Feet  
Show depth and thickness of all water, oil and gas formations.

OIL, GAS OR WATER RECORDS

CASING RECORD

FORMATION	CONTENT	FROM	TO	SIZE	PUT IN	PULLED OUT
				8-5/8	203'	none
				5 1/2"	3440'	2839'

Describe in detail the manner in which the well was plugged, indicating where the mud fluid was placed and the method or methods used in introducing it into the hole. If cement or other plugs were used, state the character of same and depth placed, from \_\_\_\_\_ feet to \_\_\_\_\_ feet for each plug set.

Checked hole, to 3406', ran sand to 3350' and mixed and dumped 5 sacks of cement. Shot pipe at 2895', 2830', worked pipe to 25" tension, left pipe on tension, worked pipe loose and pulled 96 joints. Had Allied squeeze well, pumped 4 sacks hulls, 24 gel and 140 cement, 4 gel, 1 hulls plug and 10 sacks of cement.

PLUGGING COMPLETE.

RECEIVED  
STATE CORPORATION COMMISSION  
JAN 20 1969  
CONSERVATION DIVISION  
Wichita, Kansas

(If additional description is necessary, use BACK of this sheet)  
Name of Plugging Contractor KNIGHT CASING PULLING CO., INC. 1-20-69  
Address CHASE, KANSAS


STATE OF KANSAS COUNTY OF RICE, ss.  
NOEL J. KNIGHT

(employee of owner) or (owner or operator) of the above-described well, being first duly sworn on oath, says: That I have knowledge of the facts, statements, and matters herein contained and the log of the above-described well as filed and that the same are true and correct. So help me God.

(Signature) Noel J. Knight  
CHASE, KANSAS

(Address) \_\_\_\_\_, 19 69

SUBSCRIBED AND SWORN to before me this 9th day of January, 19 69  
My commission expires February 2, 1971

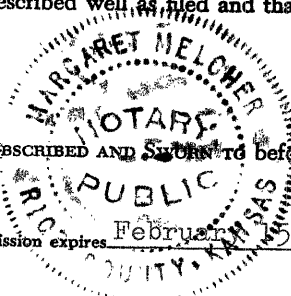

Margaret Melcher  
Notary Public.

# WELL LOG

13-163-20088-00-00

COMPANY **Clinton Oil Company**

SEC. 26 T. 25 R. 18N

FARM **Kriley** NO. **1-V**

LOC. **C - E 1/2 - NW - SW**

TOTAL DEPTH **3518'**

COUNTY **Rooks**

COMM. **12-15-67** COMP. **12-24-67**

CONTRACTOR **Garvey Drilling Company**

CASING **8 5/8" @ 210' w/170 sx**  
**5 1/2" @ 3438' w/130 sx**


ELEVATION **2020' KB**

PRODUCTION

FIGURES INDICATE BOTTOM OF FORMATIONS

- 40' Surface Clay
- 670' Shale
- 680' S Sand
- 915' Shale and Red Bed
- 1115' Sand
- 1442' Anhydrite
- 2125' Shale
- 3245' Lime and Shale
- 3285' Lime
- 3480' Lime and Shale
- 3480' Lime
- 3498' Lime and Shale
- 3518' Arbuckle
- 3518' NTD

RECEIVED  
STATE CORPORATION COMMISSION  
DEC 30 1968  
CONSERVATION DIVISION  
Wichita, Kansas

12-10-68

State of Kansas  
County of Garten } ss

I, Sam H. Stephens of Garvey Drilling Company  
upon oath state the above and foregoing is a true and correct copy of the log of the Kriley 1-V well.

Subscribed and sworn to before me this 10th day of January 19 68

My Commission Expires: November 5th, 1969

Sam H. Stephens  
Richard D. Doy  
NOTARY PUBLIC