

STATE OF KANSAS
STATE CORPORATION COMMISSION


15-163-03666-00-20
WELL PLUGGING RECORD

Give All Information Completely
Make Required Affidavit
Mail or Deliver Report to:
Conservation Division
State Corporation Commission
800 Bittling Building
Wichita, Kansas

OR
~~FORMATION PLUGGING RECORD~~

Strike out upper line
when reporting plug-
ging off formations.

NORTH

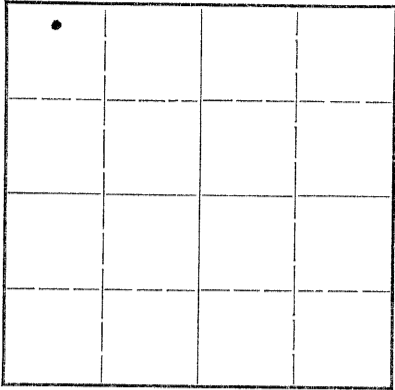

Locate well correctly on above
Section Plat

Rooks County. Sec. 34 Twp. 8 Rge. (E) 19 (W)
Location as "NE $\frac{1}{4}$ NW $\frac{1}{4}$ SW $\frac{1}{4}$ " or footage from lines. 330' fm Nth, 660' fm West lines
Lease Owner. Sinclair Oil & Gas Co. NW/4.
Lease Name. Morris Veverka Well No. 1
Office Address. Box 521 521, Tulsa, Okla
Character of Well (completed as Oil, Gas or Dry Hole). Oilwell
Date well completed. May 16 1946
Application for plugging filed. Aug 3 1949
Application for plugging approved. Aug 5 1949
Plugging commenced. Aug 4 1949
Plugging completed. Aug 8 1949
Reason for abandonment of well or producing formation.
Production depleted to a point where is no longer profitable
If a producing well is abandoned, date of last production. July 31 1949
Was permission obtained from the Conservation Division or its agents before plugging was com-
menced? yes

Name of Conservation Agent who supervised plugging of this well. C.D. Stough
Producing formation. Arbuckle Depth to top. 3407 Bottom. Total Depth of Well. 3410 Feet

Show depth and thickness of all water, oil and gas formations.

OIL, GAS OR WATER RECORDS

CASING RECORD

Formation	Content	From	To	Size	Put In	Pulled Out
Arbuckle Lime	dry	3407	3410	9-5/8"	1408'	0
				5-1/2"	3433	2290'

Describe in detail the manner in which the well was plugged, indicating where the mud fluid was placed and the method or methods used in introducing it into the hold. If cement or other plugs were used, state the character of same and depth placed, from _____ feet to _____ feet for each plug set.

3410 - 3400' rock
3400 - 3660 5 sx cement
3660 - 225' mud
225 - 180' rock bridge & 20 sx cement
180 - 20' mud
20 - 0' 10 sx cement.

RECORDED
AUG 26 1949
STATE CORP. COM. KA.

(If additional description is necessary, use BACK of this sheet)

Correspondence regarding this well should be addressed to. Mr E.H. Gibbons
Address. Box 551, Chase, Kans

STATE OF Kansas, COUNTY OF Rice, ss.

I, E.H. Gibbons (employee of owner) or (owner or operator) of the above-described well, being first duly sworn on oath, says: That I have knowledge of the facts, statements, and matters herein contained and the log of the above-described well as filed and that the same are true and correct. So help me God.


(Signature) E.H. Gibbons

Box 551 Chase, Kans (Address)

SUBSCRIBED AND SWORN to before me this 18th day of Aug 1949

My commission expires Jan 25, 1950

Notary Public. Lloyd J. Gaston

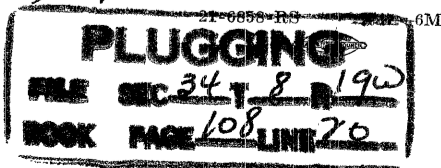

15-Ne3-03 lelele-00-00

Well Log
Sinclair Oil & Gas Co

Morris Veverka # 1
NW/4, 34-8S-19W, Rooks Co
330' fm Nth, 660' fm West lines.
Elev. 1975'

Harbar Drlg Co., began drlg 5/1/1946
Completed 5/16/1946
TD 3410' Arbuckle.
Completed for potential 254 bbl oil
of low gravity, no water..7/12/46
(pmpg 84,68 bbl in 8 hrs test)
after 1000 gal acid

Drillers Log

Surface Clay	40'
Sand	65
Shale & Shells	425
Shale	525
Shale & Sand	610
Shale	700
Sand & Shale	750
Shale & Lime	850
Lime	880
Sand	1125
Red Bed & Shale	1398
Anhydrite	1410
9-5/8" set at 1408'	
Shale & Shells	1815
Shale & Lime	1965
Shale & Shells	2020
Shale & Lime	2115
Lime & Shale	2265
Shale & Shells	2430
Lime	2655
Shale	2730
Lime & Shale	2805
Lime-broken	2865
Shale & Lime	2980
Lime-broken	3060
Lime	3410
Top Lan-Kc	3142
Top Arbuckle	3404
5 1/2" set at	3404
T.D.	3410

RECEIVED

AUG 5 - 1949

8/5/49

STATE OF KANSAS
COMMISSIONER OF GEOL. & MIN. SURV.
KANSAS

PLUGGING
FILE NO. SEC. REC. 34-8-19W
BOOK PAGE 108 LINE 20