

15-163-20431-00-00

WELL PLUGGING RECORD

Give All Information Completely  
Make Required Affidavit  
Mail or Deliver Report to:  
Conservation Division  
State Corporation Commission  
211 North Broadway P.O. Box 17027  
Wichita, Kansas 67217

Rooks County, Sec. 34 Twp. 8S Rge. (E) 19 (W)

Location as "NE/CNW&SW" or footage from lines SE NE SW

Lease Owner F & M Oil Co., Inc.

Lease Name Cerrow Well No. 1

Office Address 603 Union Center Bldg., Wichita, Kansas 67202

Character of Well (completed as Oil, Gas or Dry Hole) Dry Hole

Date well completed April 25 19 72


Application for plugging filed April 25 19 72

Application for plugging approved April 25 19 72

Plugging commenced April 25 19 72

Plugging completed April 25 19 72

Reason for abandonment of well or producing formation Dry Hole

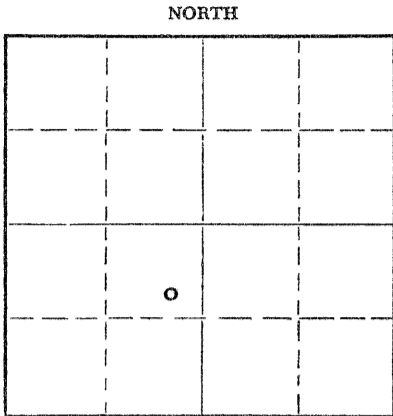

Locate well correctly on above  
Section Plat

If a producing well is abandoned, date of last production 19

Was permission obtained from the Conservation Division or its agents before plugging was commenced? Yes

Name of Conservation Agent who supervised plugging of this well Leo F. Massey, Hays, Kansas

Producing formation Depth to top Bottom Total Depth of Well 3473 Feet

Show depth and thickness of all water, oil and gas formations.

OIL, GAS OR WATER RECORDS

CASING RECORD

FORMATION	CONTENT	FROM	TO	SIZE	PUT IN	PULLED OUT
		0	218'	8 5/8"	218'	None

Describe in detail the manner in which the well was plugged, indicating where the mud fluid was placed and the method or methods used in introducing it into the hole. If cement or other plugs were used, state the character of same and depth placed, from feet to feet for each plug set.

Plug: 600' w/70 sacks cement  
210' w/20 sacks cement  
40' w/10 sacks cement

RECEIVED  
STATE CORPORATION COMMISSION

MAY 4 - 1972

CONSERVATION DIVISION  
Wichita, Kansas

5/4/72

(If additional description is necessary, use BACK of this sheet)

Name of Plugging Contractor Hellar Drilling Company, Inc.

Address 339 Union Center Bldg., Wichita, Kansas 67202

STATE OF Kansas, COUNTY OF Sedgwick, ss.


D. L. Hellar, President of Hellar Drlg. Co., Inc. (employee of owner) or (owner or operator) of the above-described well, being first duly sworn on oath, says: That I have knowledge of the facts, statements, and matters herein contained and the log of the above-described well as filed and that the same are true and correct. So help me God.

(Signature) D. L. Hellar, President  
339 Union Center Bldg., Wichita, Kansas 67202  
(Address)

SUBSCRIBED AND SWORN TO before me this 2nd day of May, 19 72

Catherine Darcey  
Notary Public.

My commission expires March 25, 1976.

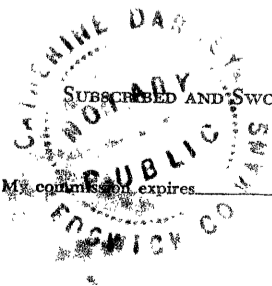

DRILLER'S LOG

COMPANY: F & M Oil Co., Inc., 603 Union Center Bldg., Wichita, Kansas 67202  
 CONTRACTOR: Hellar Drilling Company, Inc., 339 Union Center Bldg., Wichita, Ks.67202  
 LEASE: #1 Cerrow  
 LOCATION: SE NE SW 34-8S-19W, Rooks County, Kansas  
 COMMENCED: April 17, 1972  
 COMPLETED: April 25, 1972  
 CASING: Set 8 5/8" Surface Casing @ 218' w/150 sacks cement

0-220	Surface Soil & Post Rock
220-1250	Shale & Red Bed & Shells & Sand
1250-1615	Shale & Red Bed & Shells & Sand - Salt Section
1615-1865	Shale & Lime
1865-1987	Salt Section
1987-2030	Lime & Shale (Ft. Riley)
2030-2245	Lime & Shale
2245-2455	Shale & Lime
2455-2955	Lime & Shale
2955-3184	Lime (Topeka)
3184-3425	Lime
3425-3445	Cong. & Arbuckle
3445-3460	Lime
3460-3473	Arbuckle
3473	Rotary Total Depth

D & A

RECEIVED  
 STATE CORPORATION COMMISSION  
 MAY 4 - 1972  
 CONSERVATION DIVISION  
 Wichita, Kansas

5/9/72


STATE OF KANSAS )  
 ) SS  
 COUNTY OF SEDGWICK )

I, D. L. Hellar, do hereby certify that the above and foregoing is a true and correct copy of the log of the #1 Cerrow, located in SE NE SW 34-8S-19W, Rooks County, Kansas, as reflected by the files of the Hellar Drilling Company, Inc.

HELLAR DRILLING COMPANY, INC.

By *D. L. Hellar*  
 President - D. L. Hellar

Subscribed and sworn to before me, a Notary Public, in and for Sedgwick County, Kansas, this 2nd day of May, 1972.

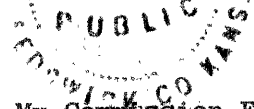

*Catherine Darcy*  
 Notary Public - Catherine Darcy

My Commission Expires:  
 March 25, 1976.