


STATE OF KANSAS
STATE CORPORATION COMMISSION

Give All Information Completely
Make Required Affidavit
Mail or Deliver Report to:
Conservation Division
State Corporation Commission
211 No. Broadway
Wichita, Kansas

15167 30325-0000
WELL PLUGGING RECORD

NORTH

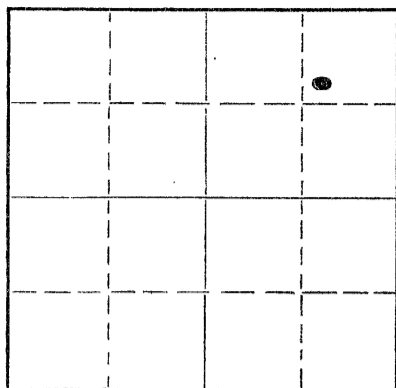

Locate well correctly on above
Section Plat

Rooks County. Sec. 34 Twp. 8 Rge. 19 (E) (W)
Location as "NE/CNW/SW" or footage from lines SW SW NE SE
Lease Owner Morris Veverka (V-Do Oil Company)
Lease Name Veverka Well No. 1
Office Address Plainville, Kansas
Character of Well (completed as Oil, Gas or Dry Hole) Dry Hole
Date well completed 2-17 1958
Application for plugging filed 2-16 1958
Application for plugging approved 2-17 1958
Plugging commenced 2-17 1958
Plugging completed 2-17 3:30 p.m. 1958
Reason for abandonment of well or producing formation Dry hole

If a producing well is abandoned, date of last production 19
Was permission obtained from the Conservation Division or its agents before plugging was commenced? Yes

Name of Conservation Agent who supervised plugging of this well Eldon Petty
Producing formation _____ Depth to top _____ Bottom _____ Total Depth of Well 3600 Feet
Show depth and thickness of all water, oil and gas formations.

OIL, GAS OR WATER RECORDS

CASING RECORD

FORMATION	CONTENT	FROM	TO	SIZE	PUT IN	PULLED OUT

Describe in detail the manner in which the well was plugged, indicating where the mud fluid was placed and the method or methods used in introducing it into the hole. If cement or other plugs were used, state the character of same and depth placed, from _____ feet to _____ feet for each plug set.

Filled hole up with heavy mud to 600', set plug, cemented through drill pipe with 20 sax cement; filled hole with heavy mud to 210'; set plug, cemented through drill pipe with 20 cement; filled hole to 40', 1/2 sack hulls 10 sax cement.
Set plug

2/20/58

(If additional description is necessary, use BACK of this sheet)

Name of Plugging Contractor Golden Cat Drilling Company
Address Wakeeney, Kansas

STATE OF Kansas, COUNTY OF Trego, ss.
Dallas Sullivan (employee of owner) or (owner or operator) of the above-described well, being first duly sworn on oath, says: That I have knowledge of the facts, statements, and matters herein contained and the log of the above-described well as filed and that the same are true and correct. So help me God.

(Signature) D. Sullivan
406 W. 4th St., Hays, Kansas (Address)

SUBSCRIBED AND SWORN TO before me this 18th day of February, 1958

My commission expires 6/23/61

Paul A. Hutchinson
Notary Public.

PLUGGING
FIL. SEC 34 8 R 19 W
BOOK PAGE 84 LINE 18

GOLDEN CAT DRILLING

and 15-163-30325-00-02

SERVICING COMPANY

Office Phone 379

Residence Phone 350

P. O. Box 611

To _____ Kansas Well Log Bureau
 _____ 508 East Murdock
 _____ Wichita, Kansas

Well _____ Overite #1 (SM/L) Sec. 34 Tw. 8 R. 19 Co. Books

Total Depth: 3600'

Elevation: 2002'

Referenced: 2-5-58

Completed: 2-17-58

See 225' 3 5/8" surface pipe

0	to	225	Surface clay, sand and shale
225		530	Shale
530		1140	Shale and sand
1140		1225	Red bed
1225		1415	Shale and shells
1415		1640	Anhydrite
1640		1720	Shale and shells
1720		2200	Shale and lime
2200		2402	Lime and shale
2402		3005	Lime and shale
3005		3145	Lime and shale
3145		3165	Lime
3165		3168	Reebner
3168		3307	Lime
3307		3415	Lime
3415		3470	Lime and shale
3470		3514	Coerty Conglomerate
3514		3600	Knuckle line
3600			TR

W. W. Pickler

2/25/58

PLUGGING
 FILE SEC. 34 T. 8 R. 19
 BOOK PAGE 84/LINE 18