


Give All Information Completely  
Make Required Affidavit  
Mail or Deliver Report to:  
Conservation Division  
State Corporation Commission  
800 Bitting Building  
Wichita, Kansas

15-163-19153-00-00

WELL PLUGGING RECORD

NORTH

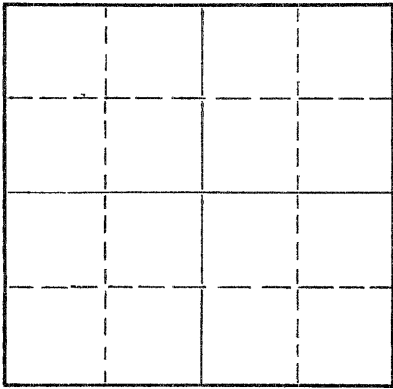

Locate well correctly on above  
Section Plat

Rooks County. Sec. 31 Twp. 8 Rge. 20 (E) (W)  
Location as "NE/CNW/SW" or footage from lines NW SW SE  
Lease Owner Leo J. Dreiling  
Lease Name Schwaller Well No. 1  
Office Address Victoria, Kansas  
Character of Well (completed as Oil, Gas or Dry Hole) Dry hole  
Date well completed 12-7 19 56  
Application for plugging filed 12-7 19 56  
Application for plugging approved 12-7 19 56  
Plugging commenced 12-7 19 56  
Plugging completed 12-7 19 56  
Reason for abandonment of well or producing formation Dry

If a producing well is abandoned, date of last production \_\_\_\_\_ 19\_\_\_\_  
Was permission obtained from the Conservation Division or its agents before plugging was commenced? Yes

Name of Conservation Agent who supervised plugging of this well Eldon Petty  
Producing formation \_\_\_\_\_ Depth to top \_\_\_\_\_ Bottom \_\_\_\_\_ Total Depth of Well 3663 Feet  
Show depth and thickness of all water, oil and gas formations.

OIL, GAS OR WATER RECORDS

CASING RECORD

FORMATION	CONTENT	FROM	TO	SIZE	PUT IN	PULLED OUT
				8 5/8"	218'	None

Describe in detail the manner in which the well was plugged, indicating where the mud fluid was placed and the method or methods used in introducing it into the hole. If cement or other plugs were used, state the character of same and depth placed, from \_\_\_\_\_ feet to \_\_\_\_\_ feet for each plug set.

Filled with heavy mud to 210'. Set plug and 1/2 sack of hulls. Spotted 15 sacks of cement then filled hole to 40'. Set plug and 1/2 sack of hulls and 10 sacks of cement.

(If additional description is necessary, use BACK of this sheet)

Name of Plugging Contractor Sidey Drilling Company  
Address Russell, Kansas

STATE OF KANSAS, COUNTY OF RUSSELL, ss.  
V. D. Sidey (employee of ~~owner~~ ~~owner~~ or operator) of the above-described well, being first duly sworn on oath, says: That I have knowledge of the facts, statements, and matters herein contained and the log of the above-described well as filed and that the same are true and correct. So help me God.

(Signature) V. D. Sidey  
Box 387 Russell, Kansas  
(Address)

SUBSCRIBED AND SWORN TO before me this 11th day of December, 19 56

My commission expires September 17, 1960

Marguerite Reynel  
Notary Public.

PLUGGING  
FILE SEC. 31 T. 8 R. 20 W  
BOOK PAGE 123 LI E. 44

RECEIVED  
DECEMBER 13 1956  
CONSERVATION DIVISION  
12-13-56

15-163-19153-00-00

**SIDEY DRILLING CO.**

BUILDING & LOAN BLDG. P. O. BOX 387  
RUSSELL, KANSAS

Company **Leo J. Dreiling Oil Company**

Sec. **31** T. **8S** R. **20W**  
Loc. **NW SW SE**

Farm **Schwaller** No. **1**

Total Depth **3663' RTD**

Comm. **11-25-56**

Comp. **12-7-56**

County **Rooks**

Shot or Treated

Contractor **Sidey Drilling Company**

Issued

Casing	
20	10
15½	8¼ 218'
12½	6¾
13%	5 5/16

Elevation

**2067 DF**

Production **D & A**

Figures Indicate Bottom of Formations

0-50	Shale
50-90	Blue shale
90-180	Shale
180-187	Shells
187-210	Shale
210-218	Lime shells
218-226	Lime shells
226-670	Shale
670-700	Shale, shells & sand
700-850	Shale
850-1030	Shale & shells
1030-1060	Sand
1060-1150	Shale shells
1150-1400	Sand
1400-1546	Red bed
1546-1640	Red rock & shale
1640-1675	Anhydrite
1675-2170	Shale & shells
2170-2195	Lime shale
2195-2275	Shale shells
2275-2360	Lime
2360-2480	Lime & shale
2480-2595	Lime
2595-2680	Lime & shale
2680-2755	Lime
2755-3320	Lime & shale
3320-3515	Lime
3515-3550	Lime
3550-3575	Conglomerate
3575-3640	Shale & lime
3640-3663	Lime shale RTD

STATE OF KANSAS, COUNTY OF RUSSELL, ss.

I, V. D. Sidey, of the Sidey Drilling Company, upon oath states that the above and foregoing is a true and correct copy of the Daily Drilling Report on your Schwaller #1 well.

PLUGGING	
WELL NO.	31 T. 8 R. 20 W.
BOOK PAGE	123 LINE 44

*V. D. Sidey*  
V. D. Sidey

RECEIVED 12-13-56

Subscribed and sworn to before me this 11th day of December, 1956.

*Marquitta Bepko*  
NOTARY PUBLIC

My Commission Expires: September 17, 1960