


Give All Information Completely
Make Required Affidavit
Mail or Deliver Report to:
Conservation Division
State Corporation Commission
211 No. Broadway
Wichita, Kansas

WELL PLUGGING RECORD

NORTH

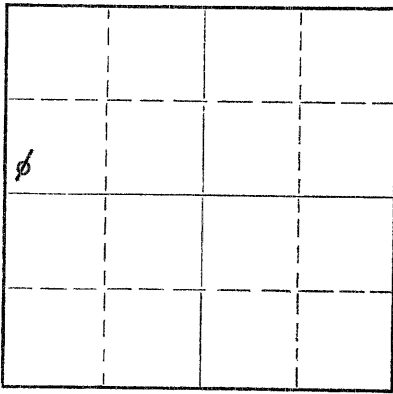

Locate well correctly on above
Section Plat

Rooks _____ County, Sec. 29 Twp. 8S Rge. 20 (6) (W)

Location as "NE/CNW/SW" or footage from lines SW SW NW

Lease Owner I. O. Miller

Lease Name Leuyer Well No. 1

Office Address 619 Brown Bldg., Wichita, Kansas

Character of Well (completed as Oil, Gas or Dry Hole) Dry Hole

Date well completed December 22, 19 56

Application for plugging filed December 22, 19 56

Application for plugging approved December 22, 19 56

Plugging commenced December 22, 19 56

Plugging completed December 22, 19 56

Reason for abandonment of well or producing formation Dry

If a producing well is abandoned, date of last production none 19 _____

Was permission obtained from the Conservation Division or its agents before plugging was commenced? Yes

Name of Conservation Agent who supervised plugging of this well Eldon Petty

Producing formation _____ Depth to top _____ Bottom _____ Total Depth of Well 3677 Feet

Show depth and thickness of all water, oil and gas formations.

OIL, GAS OR WATER RECORDS

CASING RECORD

FORMATION	CONTENT	FROM	TO	SIZE	PUT IN	PULLED OUT
				8-5/8"	245	None

Describe in detail the manner in which the well was plugged, indicating where the mud fluid was placed and the method or methods used in introducing it into the hole. If cement or other plugs were used, state the character of same and depth placed, from _____ feet to _____ feet for each plug set.

Filled hole with heavy rotary mud to 240 feet. Set plug with 1/2 sack hulls and 20 sacks of cement. Mudded hole to 40 feet. Set plug with 10 sacks of cement and 1/2 sacks of hulls.

RECEIVED
STATE CORPORATION COMMISSION
WICHITA, KANSAS

2-27-56

Name of Plugging Contractor Virginia Drilling Company, Inc.
Address Brown Bldg., Wichita, Kansas

STATE OF KANSAS, COUNTY OF SEDGWICK, ss.
F. G. Treutle

(employee of owner) or (owner or operator) of the above-described well, being first duly sworn on oath, says: That I have knowledge of the facts, statements, and matters herein contained and the log of the above-described well as filed and that the same are true and correct. So help me God.

(Signature) F. G. Treutle

619 Brown Bldg., Wichita, Kansas
(Address)

SUBSCRIBED AND SWORN to before me this 27th day of February, 19 56

My commission expires January 31, 1957

Seward S. Gouder
Notary Public.

PLUGGING
FILE REC 29 T 8 R 20 W
BOOK PAGE 41 LINE 36

15-463-00974-00-00

LECUYER #1 - SW SW NW/4 Section 29-8-20 Rocks County, Kansas
Company - I. O. Miller et al
Contractor - Virginia Drilling Co Inc.
Commenced - February 4, 1956
Completed - February 22, 1956
Elevation - 2096 HB
Total Depth - 3677 ft.

3 5/8" set at 245 ft.

FORMATION	DEPTH	TOPS:
Surface-clay-sand-shale	0- 245	
Shale-shells	245- 710	
Sand-shale-shells	710-1110	
Shale-shells	1110-1190	
Sand	1190-1400	3087 - Topeka
Shale-shells	1400-1621	3295 - Hsebner
Anhydrite	1621-1665	3314 - Toronto
Shale-shells	1665-1910	3335 - Lansing KC
Shale-line-shells	1910-2005	3558 - Base KC
Shale-shells	2005-2185	3654 - Arbuckle
Line-shale	2185-2385	
Line brkn	2385-2435	
Line-shale	2435-2720	
Brkn line	2720-2765	
Shale-line	2765-3087	
Line	3087-3677 T.D.	

Murles Hawkins
Murles Hawkins

Subscribed and sworn to before me, a Notary Public,
this 23rd day of February, 1956.

Inez M. Underwood
Notary Public - Inez M. Underwood

My commission expires: March 15, 1958.

RECEIVED
STATE COMMISSION OF MINES
FEB 27 1956

2-27-56

PLUGGING
NOV 29 8 20W
BOOK PAGE 41 LINE 36