


Give All Information Completely
Make Required Affidavit
Mail or Deliver Report to:
Conservation Division
State Corporation Commission
212 No. Market
Wichita, Kansas

WELL PLUGGING RECORD

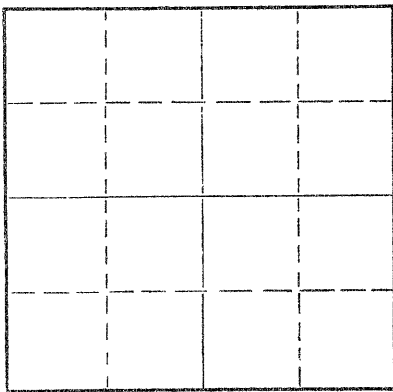

Locate well correctly on above
Section Plat

Rooks County. Sec. 30 Twp. 8 Rge. (E) 20 (W)
Location as "NE/CNW/SW" or footage from lines. C S/2 SE NW
Lease Owner National Associated Petroleum Co.
Lease Name Thibault-Brin Comm Well No. 1
Office Address Petroleum Bldg - Tulsa, Okla. 74103
Character of Well (completed as Oil, Gas or Dry Hole) D & A
Date well completed 11/26 19 68
Application for plugging filed 11/26 19 68
Application for plugging approved 11/26 19 68
Plugging commenced 11/26 19 68
Plugging completed 11/26 19 68
Reason for abandonment of well or producing formation _____

If a producing well is abandoned, date of last production _____ 19____
Was permission obtained from the Conservation Division or its agents before plugging was commenced? yes

Name of Conservation Agent who supervised plugging of this well _____
Producing formation _____ Depth to top _____ Bottom _____ Total Depth of Well _____ Feet
Show depth and thickness of all water, oil and gas formations.

OIL, GAS OR WATER RECORDS

CASING RECORD

FORMATION	CONTENT	FROM	TO	SIZE	PUT IN	PULLED OUT
				8-5/8"	210'	

Describe in detail the manner in which the well was plugged, indicating where the mud fluid was placed and the method or methods used in introducing it into the hole. If cement or other plugs were used, state the character of same and depth placed, from _____ feet to _____ feet for each plug set.

Mud to 720'
70 sacks cement
Mud to 210'
20 sacks cement
Mud to 40'
10 sacks cement
2 sacks in rat hole

RECEIVED
STATE CORPORATION COMMISSION
JAN 9 1969
CONSERVATION DIVISION
Wichita, Kansas

1-9-69

(If additional description is necessary, use BACK of this sheet)

Name of Plugging Contractor Broken Arrow Drilling Co
Address Petroleum Bldg. Tulsa, Oklahoma 74103

STATE OF Oklahoma, COUNTY OF Tulsa, ss.
Jack Roberts (employee of owner) or (owner or operator) of the above-described well, being first duly sworn on oath, says: That I have knowledge of the facts, statements, and matters herein contained and the log of the above-described well as filed and that the same are true and correct. So help me God.

(Signature) Jack Roberts
Tulsa Oklahoma (Address)

SUBSCRIBED AND SWORN TO before me this 8th day of January, 19 69

My commission expires February 31, 1969 Maguid S. Provine Notary Public.

15-163-20156-00-00



Broken Arrow Drilling Company

ROOM 409 PETROLEUM BUILDING • TULSA, OKLAHOMA 74103 • AC 918-582-1181

DRILLER'S LOG

COMPANY: National Associated Petroleum Co.
Petroleum Building
Tulsa, Oklahoma

FARM: THIBAUT-BRIN COMM. NO. 1

TOTAL DEPTH 3796

COMM.: 11-17-68 COMP.: 11-26-68

CONTRACTOR: Broken Arrow Drilling Company
Petroleum Building
Tulsa, Oklahoma

SEC. 30 TWP. 8 RGE. 20W

LOCATION: C S/2 SE NW

COUNTY: ROOKS

ELEVATION 2024'

PRODUCTION: D & A

CASING RECORD: 210' - New 8-5/8"

CEMENT RECORD: 200 sacks cement; 200# AC;
200# CC

0' - 213'	Soil
213' - 1415'	Sand & Shale
1415' - 1577'	Shale
1577' - 1613'	Anhydrite
1613' - 1640'	Red-bed
1640' - 2140'	Sand & Shale
2140' - 2360'	Lime
2630' - 2675'	Lime & Shale
2675' - 2765'	Lime
2765' - 3130'	Shale & Lime
3130' - 3675'	Lime w/Sand Stringers
3675' - 3796'	Lime
T.D. - 3796'	

RECEIVED
STATE CORPORATION COMMISSION
JAN 9 1969
CONSERVATION DIVISION
Wichita, Kansas

1-9-69

We hereby certify that the above is a true copy of the Driller's Log for the above described well.

BROKEN ARROW DRILLING COMPANY

By:

Jack Roberts
Jack Roberts

Subscribed and sworn to before me this 8th day of January, 1969

My Commission expires:
February 21, 1969

Marilee S. Preneke
Notary Public