

15-163-00094-00-00

STATE OF KANSAS
STATE CORPORATION COMMISSION


WELL PLUGGING RECORD

Give All Information Completely
Make Required Affidavit
Mail or Deliver Report to:
Conservation Division
State Corporation Commission
800 Biting Building
Wichita, Kansas

OR
FORMATION PLUGGING RECORD

Strike out upper line
when reporting plugging
off formations.

NORTH

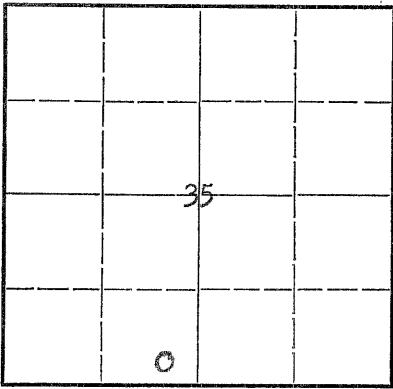

Locate well correctly on above
Section Plat

Rooks _____ County. Sec. 35 Twp. 8S Rge. ~~(7S)~~ 20 (W)
Location as "NE $\frac{1}{4}$ NW $\frac{1}{4}$ SW $\frac{1}{4}$ " or footage from lines. SE SE SW
Lease Owner. Bridgeport Oil Company, Inc.
Lease Name. Meade "A"
Office Address. 914 Central Building - Wichita 2, Kansas
Character of Well (completed as Oil, Gas or Dry Hole). Dry Hole
Date well completed. 4/30/19 47
Application for plugging filed. 4/30/19 47
Application for plugging approved. 4/30/19 47
Plugging commenced. 4/30/19 47
Plugging completed. 4/30/19 47
Reason for abandonment of well or producing formation. Dry Hole

If a producing well is abandoned, date of last production. 19____
Was permission obtained from the Conservation Division or its agents before plugging was commenced? Yes

Name of Conservation Agent who supervised plugging of this well. Mr. C. D. Stough - Box 105, Hays, Kansas
Producing formation. _____ Depth to top. _____ Bottom. _____ Total Depth of Well. 3678 Feet

Show depth and thickness of all water, oil and gas formations.

OIL, GAS OR WATER RECORDS

CASING RECORD

Formation	Content	From	To	Size	Put In	Pulled Out
				8-5/8"	210'	None

Describe in detail the manner in which the well was plugged, indicating where the mud fluid was placed and the method or methods used in introducing it into the hole. If cement or other plugs were used, state the character of same and depth placed, from _____ feet to _____ feet for each plug set.

Mud from 3678' to 210'

Set plug at 210' with 15 sacks cement on top of plug.

Mud from 210' to 15'

Set plug at 15' with 5 sacks cement to base of cellar.

MAY 1947
9-47

(If additional description is necessary, use BACK of this sheet)

Correspondence regarding this well should be addressed to Bridgeport Oil Company, Inc.
Address. 914 Central Building - Wichita 2, Kansas

STATE OF Kansas, COUNTY OF Sedgwick, ss.
Frank Leach

(employee of owner) or (owner or operator) of the above-described well,
being first duly sworn on oath, says: That I have knowledge of the facts, statements, and matters herein contained and the log of the above-described well as filed and that the same are true and correct. So help me God.

(Signature)

Wichita, Kansas

(Address)

SUBSCRIBED AND SWORN TO before me this 8th day of May, 19 47

My commission expires January 16, 1950.

Notary Public.

PLUGGING
FILE SEC 35 T 8 R 20 W
BOOK PAGE 108 LINE 35

15-163-00094-00-00

BRIDGEPORT OIL COMPANY, Inc.
914 Central Building
Wichita 2, Kansas

Well Log----- Meade "A" No. 1
SE SE SW 35-89-20W
Rooks County, Kansas

Elevation----- 2085' (I&S)
Date Commenced----- 4-16-47
Date Completed----- 4-30-47

CASING RECORD:
8-5/8" casing cemented at 210' with
150 sacks cement.

LOG

FORMATION TOPS - DF

0	210	Shale & Shells		
210	1055	Shale, Shells & Red Bed	Top Kansas City	3303'
1055	1090	Shale		
1090	1300	Sand & Shale	Top Conglomerate	3589'
1300	1560	Shale & Shells		
1560	1600	Lime	Top Arbuckle	3650'
1600	1990	Shale & Shells		
1990	2030	Shale & Lime		
2030	2040	Lime		
2040	2200	Shale & Lime Shells		
2200	2290	Lime		
2290	2385	Lime & Shale		
2385	2455	Lime		
2455	2575	Lime & Shale		
2575	2620	Lime		
2620	2975	Lime & Shale		
2975	3080	Shale & Shells		
3080	3190	Lime & Shale		
3190	3598	Lime		
3598	3655	Conglomerate "cherty"		
3655	3678	Lime		
3678		T.D. PLUGGED AND ABANDONED 4/30/47.		

MAY 3 1947

59-47

I, Frank Leach, do hereby certify that the above log is correct to the best of my knowledge and belief.

BRIDGEPORT OIL COMPANY, Inc.

By: Frank Leach

PLUGGING
FILE SEC 35 T 8 R 20W
BOOK PAGE 108 LINE 35