


15-163-00325-00-00

WELL PLUGGING RECORD

Give All Information Completely
Make Required Affidavit
Mail or Deliver Report to:
Conservation Division
State Corporation Commission
800 Bitting Building
Wichita, Kansas

NORTH

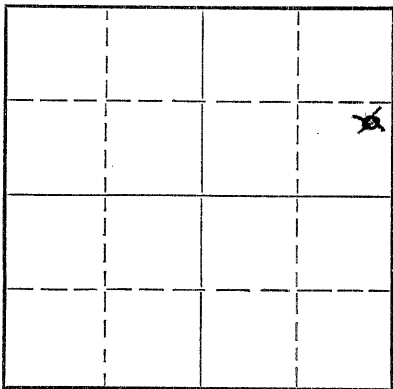

Locate well correctly on above
Section Plat

Rooks County. Sec. 35 Twp. 8S Rge. 20 (W) (W)
Location as "NE/CNW $\frac{1}{4}$ SW $\frac{1}{4}$ " or footage from lines NE SE NE
Lease Owner Creekmore Drilling Company & Deep Rock Oil Corporation
Lease Name Baldwin Well No. 1
Office Address Tulsa, Oklahoma
Character of Well (completed as Oil, Gas or Dry Hole) Dry Hole
Date well completed November 22 19 51
Application for plugging filed November 29 19 51
Application for plugging approved 19 _____
Plugging commenced November 23 19 51
Plugging completed November 24 19 51
Reason for abandonment of well or producing formation _____

If a producing well is abandoned, date of last production _____ 19 _____
Was permission obtained from the Conservation Division or its agents before plugging was commenced? Yes, permission was obtained from Mr. Eldon Petty

Name of Conservation Agent who supervised plugging of this well Mr. Eldon Petty
Producing formation Arbuckle Depth to top 3594' Bottom 3636' Total Depth of Well 3636' Feet
Show depth and thickness of all water, oil and gas formations.

OIL, GAS OR WATER RECORDS

CASING RECORD

Formation	Content	From	To	Size	Put In	Pulled Out
				8-5/8"	115'	None

Describe in detail the manner in which the well was plugged, indicating where the mud fluid was placed and the method or methods used in introducing it into the hole. If cement or other plugs were used, state the character of same and depth placed, from _____ feet to _____ feet for each plug set.

Filled with heavy mud from 3636' to 140'. Put in 35 sacks regular cement, 100# calcium chloride, filled to 35'. Put in 1/2 sack hulls and 9 sacks cement, filled from 35' to top of hole and into cellar.

STATE CORPORATION COMMISSION
DEC-7-1951
CONSERVATION DIVISION
Wichita, Kansas

(If additional description is necessary, use BACK of this sheet)
Name of Plugging Contractor Creekmore Drilling Company 12-7-51
Address Tulsa, Oklahoma

STATE OF Kansas, COUNTY OF Reno, ss.
Jack Smith (employee of owner) or (owner or operator) of the above-described well,
being first duly sworn on oath, says: That I have knowledge of the facts, statements, and matters herein contained and the log of the above-described well as filed and that the same are true and correct. So help me God.

(Signature) Jack Smith
Box #1146, Hutchinson, Kansas
(Address)

SUBSCRIBED AND SWORN to before me this 6th day of December, 19 51

My commission expires August 15, 1955 Malby Bridgeman Notary Public.

PLUGGING
FILE NO. 3578-201
DATE 1271951

15-163- 00325-00-00

Creekmore Drilling Company &
Deep Rock Oil Corporation

Baldwin Well No. 1
Section 35-8S-20W
Rooks County, Kansas

Formation:

Surface clay and shale	00'	116'
Shale and sand	116'	866'
Redbed and shale	866'	1580'
Anhydrite	1580'	1620'
Shale	1620'	1780'
Shale and lime	1780'	2001'
Lime	2001'	2275'
Lime and shale	2275'	2970'
Shale and lime	2970'	3070'
Lime and shale	3070'	3210'
Lime	3210'	3560'
Lime and shale	3560'	3636'
Total Depth		3636'

35 8 20W
127 1/4

DEC - 6 1951
CONSERVATION DIVISION
Wichita, Kansas
12-6-51