


STATE OF KANSAS
STATE CORPORATION COMMISSION

15-065-00358-00-00

WELL PLUGGING RECORD

Give All Information Completely
Make Required Affidavit
Mail or Deliver Report to:
Conservation Division
State Corporation Commission
800 Bitting Building
Wichita, Kansas

Graham County. Sec. 5 Twp. 8 Rge. 21 (E) W (W)
Location as "NE/CNW $\frac{1}{4}$ SW $\frac{1}{4}$ " or footage from lines SE/4 SE/4 NW/4
Lease Owner Prime Drilling Company & Davis Brothers
Lease Name Gosselin Well No. 1
Office Address 1516 Liberty Bank Bldg., Okla. City, Okla.
Character of Well (completed as Oil, Gas or Dry Hole) Dry Hole
Date well completed 6-8 19 52
Application for plugging filed 6-8 19 52
Application for plugging approved 6-8 19 52
Plugging commenced 6-8 19 52
Plugging completed 6-8 19 52
Reason for abandonment of well or producing formation

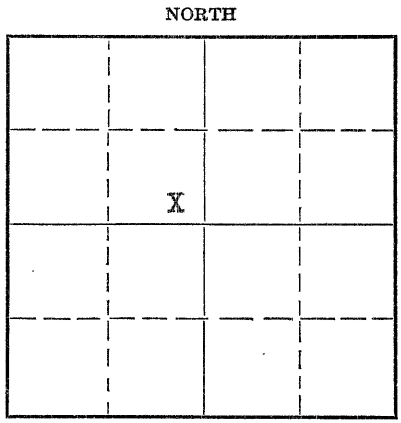

Locate well correctly on above Section Plat

If a producing well is abandoned, date of last production 19
Was permission obtained from the Conservation Division or its agents before plugging was commenced? Yes

Name of Conservation Agent who supervised plugging of this well Eldon Petty, Hays, Kansas
Producing formation Depth to top Bottom Total Depth of Well 3648 Feet
Show depth and thickness of all water, oil and gas formations.

OIL, GAS OR WATER RECORDS CASING RECORD

Formation	Content	From	To	Size	Put In	Pulled Out
				8-5/8	185	None

Describe in detail the manner in which the well was plugged, indicating where the mud fluid was placed and the method or methods used in introducing it into the hole. If cement or other plugs were used, state the character of same and depth placed, from feet to feet for each plug set.

Filled hole with heavy drilling mud to 180 feet, set plug and cemented with 15 sacks cement. Filled hole with heavy drilling mud to 40 feet, set plug and cemented with 10 sacks cement to bottom of cellar.

(If additional description is necessary, use BACK of this sheet)

Name of Plugging Contractor Prime Drilling Company
Address 1516 Liberty Bank Bldg., Oklahoma City, Oklahoma

STATE OF Oklahoma, COUNTY OF Oklahoma, ss.
L. J. Kruse (employee of owner) or (owner or operator) of the above-described well, being first duly sworn on oath, says: That I have knowledge of the facts, statements, and matters herein contained and the log of the above-described well as filed and that the same are true and correct. So help me God.

(Signature) *L. J. Kruse*
Oklahoma City, Oklahoma (Address)

SUBSCRIBED AND SWORN to before me this 10th day of June, 1952

My commission expires October 24, 1955

William H. Wright
Notary Public

PLUGGING
5 8 21W
22 12

23-8390-6 6-51-20M
JUN 11 1952
CONSERVATION DIVISION
Wichita, Kansas
6-11-52

15-065-00358-00-00

PRIME DRILLING COMPANY & DAVIS BROTHERS

SE/4 SE/4 NW/4 Sec. 5-8S-21W
Graham County, Kans.

GOSSELIN # 1

<u>FORMATION</u>	<u>FROM</u>	<u>TO</u>	<u>REMARKS</u>
Surface Rock & Clay	0	45	
Sand	45	80	
Shale	80	130	
Sand & Shale	130	185	
Shale	185	450	
Shale & Shells	450	665	
Sand	665	705	
Shale & Shells	705	1040	
Shale & Sand	1040	1160	
Sand	1160	1370	
Red Bed Shale & Shells	1370	1650	
Anhydrite	1650	1685	
Shale & Shells Pyrite	1685	1790	
Shale Shells & Pyrite	1790	1840	
Shale Shells Red Bed	1840	2095	
Shale & Lime	2095	3190	
Lime & Shale	3190	3260	
Lime	3260	3482	
Shale & Lime	3482	3505	
Shale Lime & Chert	3505	3648	
Total Depth		3648'	

8-5/8" C.S.A. @ 185'. Cemented with 125 Sacks Cement

I hereby certify the foregoing to be a true and accurate Driller's Log of the formations encountered in the above well.

PRIME DRILLING COMPANY

By: L. J. Kruse
L. J. Kruse
Secretary

Subscribed and sworn to before me this 10th day of June, 1952.

Lillian Wright
Notary Public

My Commission Expires:
October 21, 1955

PLUGGING
FILE SEC 5-8-21W
BOOK PAGE 28 LINE 18

RECEIVED
STATE COMMISSION
JUN 11 1952
DIVISION
Wichita, Kansas

6-11-52