

15-065-00416-00-00

STATE OF KANSAS
STATE CORPORATION COMMISSION


Give All Information Completely
Make Required Affidavit
Mail or Deliver Report to:
Conservation Division
State Corporation Commission
800 Bittling Building
Wichita, Kansas

WELL PLUGGING RECORD

SE SE SE County. Sec. 5 Twp. 8S Rge. 21W (E) W (W)

Location as "NE/CNW/SW" or footage from lines SE SE SE
Lease Owner Fred B. Anschutz
Lease Name Kenyon Well No. 1
Office Address 709 Union National Bank Building
Character of Well (completed as Oil, Gas or Dry Hole) Dry Hole
Date well completed October 16, 19 54
Application for plugging filed October 16, 19 54
Application for plugging approved October 16, 19 54
Plugging commenced October 16, 19 54
Plugging completed October 16, 19 54
Reason for abandonment of well or producing formation Dry Hole

NORTH

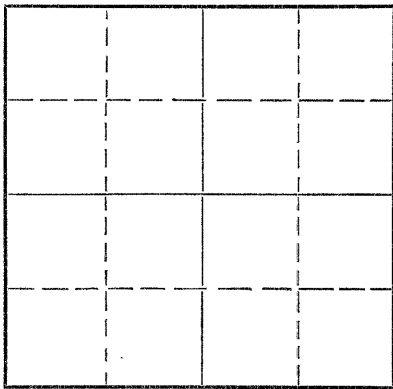

Locate well correctly on above
Section Plat

If a producing well is abandoned, date of last production _____ 19 ____
Was permission obtained from the Conservation Division or its agents before plugging was commenced? Yes

Name of Conservation Agent who supervised plugging of this well Eldon Petty - Hays, Kansas
Producing formation _____ Depth to top _____ Bottom _____ Total Depth of Well 3610' Feet
Show depth and thickness of all water, oil and gas formations.

OIL, GAS OR WATER RECORDS

CASING RECORD

FORMATION	CONTENT	FROM	TO	SIZE	PUT IN	PULLED OUT
				8 5/8"	172'	None

Describe in detail the manner in which the well was plugged, indicating where the mud fluid was placed and the method or methods used in introducing it into the hole. If cement or other plugs were used, state the character of same and depth placed, from _____ feet to _____ feet for each plug set.

Bottom Plug set at 300' w/ 20 sacks of cement
Top Plug set at 30' w/ 10 sacks of cement

(If additional description is necessary, use BACK of this sheet)
Name of Plugging Contractor Anschutz Drilling Co., Inc. 10-20-54
Address 709 Union National Bank Building

STATE OF Kansas, COUNTY OF Sedgwick, ss.
E. G. Koelling (employee of owner) or (owner or operator) of the above-described well, being first duly sworn on oath, says: That I have knowledge of the facts, statements, and matters herein contained and the log of the above-described well as filed and that the same are true and correct. So help me God.


(Signature) E. G. Koelling
709 Union National Bank Building
(Address)

SUBSCRIBED AND SWORN TO before me this 18th day of October, 19 54

Charlene Barber
Notary Public.

My commission expires July 28, 1958

24-7368-S 3-53-20M

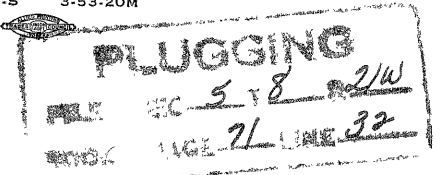

DRILLER'S LOG

Fred B. Anschutz
Kenyon #1
SE SE SE 5-8S-21W
Graham County, Kansas

<u>TO</u>	<u>FROM</u>	
0	175	Shale
175	1005	Shale & Shells
1005	1180	Shale
1180	1350	Sand
1350	1430	Shale & Red Bed
1430	1630	Red Bed, Shale & Shells
1630	1663	Anhydrite
1663	2240	Shale & Shells
2240	2410	Lime & Shale
2410	2540	Shale & Lime
2540	2755	Lime & Shale
2755	2870	Shale
2870	3093	Shale & Shells
3093	3308	Lime & Shale
3308	3485	Lime
3485	3532	Lime & Shale
3532	3561	Conglomerate
3561	3575	Lime & Shale
3575	3590	Lime
3590	3610	Arbuckle
	3610	ROTARY TOTAL DEPTH

COMMENCED: 10-6-54
COMPLETED: 10-16-54

CASING RECORD:

Set 172.98' of 8 5/8" surface casing with 150 sacks of cement.

D & A

STATE OF KANSAS)
) SS
COUNTY OF SEDGWICK)

I hereby affirm that the above and foregoing is a true and correct copy of the log of the Kenyon #1 located SE SE SE of Section 5-8S-21W, Graham County, Kansas.

ANSCHUTZ DRILLING CO., INC.

BY: *E. G. Koelling*
E. G. Koelling

Subscribed and sworn to before me this 19th day of October, 1954.

Charlene Barbour
Notary Public

My Commission Expires: July 28, 1958

