


13-065-03252-00-00

Give All Information Completely  
Make Required Affidavit  
Mail or Deliver Report to:  
Conservation Division  
State Corporation Commission  
212 North Market, Insurance Bldg.  
Wichita, Kansas

WELL PLUGGING RECORD

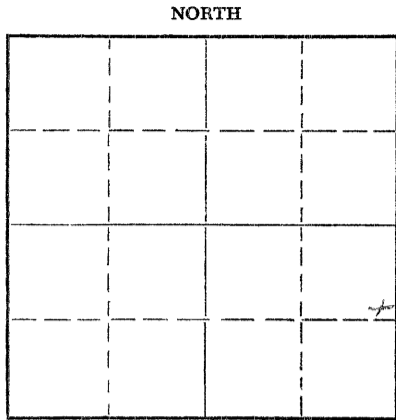

Locate well correctly on above Section Plat

Graham County. Sec. 5 Twp. 8 Rge. 21 (E) (W)  
Location as "NE/CNW/SW" or footage from lines SE NE SE  
Lease Owner John P. Jennings  
Lease Name Kenyon Well No. 2  
Office Address 917 Minnesota Ave., Kansas City, Kansas  
Character of Well (completed as Oil, Gas or Dry Hole) oil  
Date well completed \_\_\_\_\_ 19\_\_\_\_  
Application for plugging filed 8-3-59 19\_\_\_\_  
Application for plugging approved 8-5-59 19\_\_\_\_  
Plugging commenced 8-8-59 19\_\_\_\_  
Plugging completed 8-10-59 19\_\_\_\_  
Reason for abandonment of well or producing formation dry

If a producing well is abandoned, date of last production \_\_\_\_\_ 19\_\_\_\_  
Was permission obtained from the Conservation Division or its agents before plugging was commenced? yes

Name of Conservation Agent who supervised plugging of this well A. D. Fabricius  
Producing formation \_\_\_\_\_ Depth to top \_\_\_\_\_ Bottom \_\_\_\_\_ Total Depth of Well 3620 Feet  
Show depth and thickness of all water, oil and gas formations.

OIL, GAS OR WATER RECORDS

CASING RECORD

FORMATION	CONTENT	FROM	TO	SIZE	PUT IN	PULLED OUT

Describe in detail the manner in which the well was plugged, indicating where the mud fluid was placed and the method or methods used in introducing it into the hole. If cement or other plugs were used, state the character of same and depth placed, from \_\_\_\_\_ feet to \_\_\_\_\_ feet for each plug set.

Sanded back to 3456' mixed and run 3 sacks cement with dump bailer  
Bailed fluid and filled hole with mud to 175' set 10' rock bridge  
mixed and run 25 sacks cement with dump bailer,  
Mud to 40' set 10' rock bridge with 10 sacks cement to base of cellar.

RECEIVED  
STATE COMMISSION

AUG 14 1959

CONSERVATION DIVISION  
Wichita, Kansas

(If additional description is necessary, use BACK of this sheet)  
Name of Plugging Contractor Southwest Casing Pulling Co., Inc. 8-14-59  
Address Box 364, Great Bend, Kansas

STATE OF Kansas COUNTY OF Barton, ss.  
Southwest Casing Pulling Co., Inc. (employee of owner) or (owner or operator) of the above-described well, being first duly sworn on oath, says: That I have knowledge of the facts, statements, and matters herein contained and the log of the above-described well as filed and that the same are true and correct. So help me God.

(Signature) Roy L. Myers Sec. Treas.  
Box 364, Great Bend, Kansas  
(Address)

SUBSCRIBED AND SWORN TO before me this 13 day of August, 19 59

My commission expires December 18, 1962

Juanita R. Myers  
Notary Public.

PLUGGING  
FILE SEC. 5 T. 8 R. 21 W  
BOOK PAGE 57 LINE 37

15-065-03252-00-00

WELL DRILLING LOG


CONTRACTOR: Prime Drilling Company  
COMM: 12/26/57  
COMP: 1/6/58

Formations:

Remarks: Set 3-5/8" surface casing  
at 176' cemented with 135 sacks  
cement.

Surface clay	100'
Shale	177'
Shale & Shells	680'
Sand	775'
Shale & Shells	1180'
Sand	1390'
Red bed & shale	1570'
Red bed & Shells	2570'
Anhydrite	1705'
Shale & Shells	1990'
Shale & Lime	2320'
Lime & shale	2570'
Shale & Lime	2705'
Lime & Shale	3100'
Lime	3515'
Lime & Shale	3620'
Rotary total depth	3620'

Set 5-1/2" casing at 3560' cemented  
with 125 sacks Pozmix.

The log is as shown and is  
correct to the best of our knowledge  
and belief.

R. E. McNeel

8-4-59

