


WELL PLUGGING RECORD

Give All Information Completely
Make Required Affidavit
Mail or Deliver Report to:
Conservation Division
State Corporation Commission
212 No. Market
Wichita, Kansas

NORTH

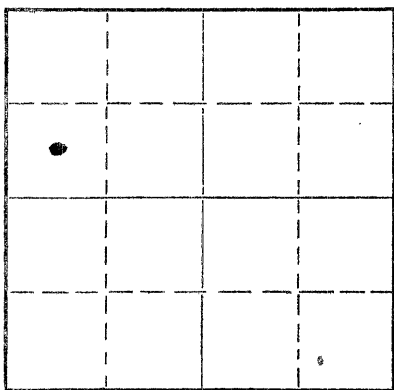

Locate well correctly on above
Section Plat

Rooks County. Sec. 34 Twp. 8 Rge. (E) 18W (W)
Location as "NE/CNW/SW" or footage from lines C-SW-NW
Lease Owner Two-Way Oil Company
Lease Name Harris Well No. 1
Office Address 1000 Southwest 2nd, Plainville, Kansas 67663
Character of Well (completed as Oil, Gas or Dry Hole) Dry hole
Date well completed Oct. 16 19 77
Application for plugging filed (oral) Oct. 16 19 77
Application for plugging approved Oct. 16 19 77
Plugging commenced Oct. 16 19 77
Plugging completed Oct. 16 19 77
Reason for abandonment of well or producing formation Dry hole

If a producing well is abandoned, date of last production 19
Was permission obtained from the Conservation Division or its agents before plugging was commenced? Yes

Name of Conservation Agent who supervised plugging of this well Leo Massey
Producing formation Depth to top Bottom Total Depth of Well 3405 Feet
Show depth and thickness of all water, oil and gas formations.

OIL, GAS OR WATER RECORDS

CASING RECORD

FORMATION	CONTENT	FROM	TO	SIZE	PUT IN	PULLED OUT
Surface		0	172	8 5/8"	x	

Describe in detail the manner in which the well was plugged, indicating where the mud fluid was placed and the method or methods used in introducing it into the hole. If cement or other plugs were used, state the character of same and depth placed, from feet to feet for each plug set.

1st. plug at 550 feet with 70 sacks cement 50-50 poz. 6% gel.
2nd. plug at 160 feet with 20 sacks cement 50-50 poz. 6% gel.
3rd. plug at 40 feet with 10 sacks cement 50-50 poz. 6% gel.

OCT 22 1977
OCT 22 1977
NOTARY PUBLIC
WICHITA, KANSAS

(If additional description is necessary, use BACK of this sheet)

Name of Plugging Contractor Allied Cementing Co., Inc.
Address Plainville, Kansas 67663

STATE OF Kansas, COUNTY OF Graham, ss.
Jerry M. Helberg (employee of owner) or (owner or operator) of the above-described well, being first duly sworn on oath, says: That I have knowledge of the facts, statements, and matters herein contained and the log of the above-described well as filed and that the same are true and correct. So help me God.

(Signature) Jerry M Helberg
Box 32 Morland, Kansas 67650
(Address)

SUBSCRIBED AND SWORN TO before me this 21 day of October, 19 77

My commission expires
STATE NOTARY PUBLIC
FAVE E. MINIUM
Graham County, Ks.
My Comm. Exp. Oct. 13, 1978

Faye E. Minium
Notary Public.

DRILLERS LOG

HARRIS #1

CASING RECORD:

8 5/8" set at 172'

TOTAL DEPTH:

3405'

OPERATOR: TWO-WAY OIL COMPANY

CONTRACTOR: Helberg Oil Company

COMMENCED: October 8, 1977

COMPLETED: October 16, 1977

DESCRIPTION:

C SW NW
Sec. 34-8-18, Rooks County, Kansas

FORMATION	FROM	TO	REMARKS
Sand	0	180	
Shale & Sand	180	964	
Shale & Sand	964	1313	
Anhydrite	1313	1348	
Shale	1348	1365	
Shale & Sand	1365	1611	
Shale & Sand	1611	1900	
Shale & Sand	1900	2065	
Shale & Shells	2065	2172	
Shale	2172	2240	
Shale	2240	2377	
Shale	2377	2479	
Shale	2479	2529	
Shale	2529	2668	
Shale	2668	2793	
Shale	2793	2888	
Shale	2888	2993	
Shale	2993	3083	
Shale	3083	3140	
Lime	3140	3175	
Lime	3175	3222	
Shale	3222	3280	
Lime	3280	3335	
Lime	3335	3400	
Lime	3400	3405	
T.D.	3405		D & A

OCT 22 1977
OCT 22 1977
CONSERVATION DIVISION
WICHITA, KANSAS

I certify that this is a true and correct copy of the above log to the best of my knowledge.

HELBERG OIL COMPANY

Jerry M. Helberg
Jerry M. Helberg

Subscribed and sworn to before me this 21st day of October, 1977.

Jaye E. Murrison
Notary Public

My commission expires _____

