


STATE OF KANSAS
STATE CORPORATION COMMISSION
CONSERVATION DIVISION
P. O. BOX 17027
WICHITA, KANSAS 67217

FORM CP-4

WELL PLUGGING RECORD

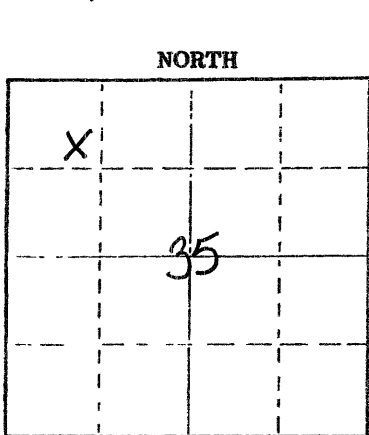

Rooks _____ County. Sec. 35 Twp. 8S Rge. 18 (W)

Location as "NE/CNW/SW" or footage from lines SE NW NW

Lease Owner Abercrombie Drilling, Inc.

Lease Name RADKE Well No. #2

Office Address 801 Union Center, Wichita, Ks. 67202

Character of Well (completed as Oil, Gas or Dry Hole) Dry Hole

Date well completed March 9, 1976

Application for plugging filed (verbal) March 9, 1976

Application for plugging approved (verbal) March 9, 1976

Plugging commenced March 9, 1976

Plugging completed March 9, 1976

Reason for abandonment of well or producing formation No commercial quantity of oil or gas encountered.

If a producing well is abandoned, date of last production 19

Was permission obtained from the Conservation Division or its agents before plugging was commenced? Yes

Name of Conservation Agent who supervised plugging of this well Gilbert Balthazor

Producing formation _____ Depth to top _____ Bottom _____ Total Depth of Well 3470'

Show depth and thickness of all water, oil and gas formations.

OIL, GAS OR WATER RECORDS

CASING RECORD

FORMATION	CONTENT	FROM	TO	SIZE	PUT IN	PULLED OUT
				8 5/8"	214' K.B.	none

Describe in detail the manner in which the well was plugged, indicating where the mud fluid was placed and the method or methods used in introducing it into the hole. If cement or other plugs were used, state the character of same and depth placed, from _____ feet to _____ feet for each plug set.

1st Plug was Set @ 500' with 50 sx. cement
 2nd Plug was Set @ 185' with 25 sx. cement
 3rd Plug was Set @ 40' with 10 sx. cement

MAR 16 1976
 Mar 16/1976

(If additional description is necessary, use BACK of this sheet)

Name of Plugging Contractor Abercrombie Drilling, Inc.

Address 801 Union Center, Wichita, Kansas 67202

STATE OF KANSAS COUNTY OF SEDGWICK ss.
Jerry A. Langrehr-Exec. V.P. (employee of owner) or (owner or operator) of the above-described

well, being first duly sworn on oath, says: That I have knowledge of the facts, statements, and matters herein contained and the log of the above-described well as filed and that the same are true and correct. So help me God.

(Signature) Jerry A. Langrehr
801 Union Center, Wichita, Ks. 67202
 (Address)

SUBSCRIBED AND SWORN TO before me this 12th day of March, 1976

My commission expires February 18, 1980
Diane Steincamp
 Diane Steincamp Notary Public.

