


STATE OF KANSAS  
STATE CORPORATION COMMISSION  
CONSERVATION DIVISION  
P. O. BOX 17027  
WICHITA, KANSAS 67217

FORM CP-4

WELL PLUGGING RECORD

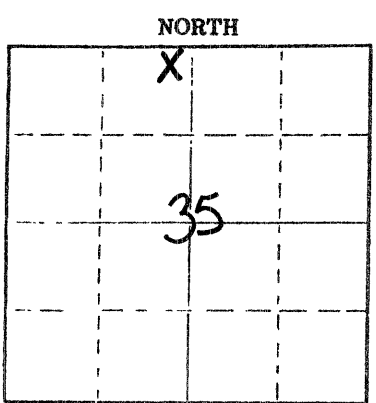

Rooks \_\_\_\_\_ County. Sec. 35 Twp. 8S Rge. XIX 18 (W)  
Location as "NE/CNW/SW" or footage from lines C NE NE NW  
Lease Owner Abercrombie Drilling, Inc.  
Lease Name RADKE "B" Well No. 1  
Office Address 801 Union Center, Wichita, Kansas 67202  
Character of Well (completed as Oil, Gas or Dry Hole) Dry Hole  
Date well completed March 15 19 76  
Application for plugging filed (verbally) March 15 19 76  
Application for plugging approved (verbally) March 15 19 76  
Plugging commenced March 15 19 76  
Plugging completed March 15 19 76  
Reason for abandonment of well or producing formation No commercial quantity of oil or gas encountered.  
If a producing well is abandoned, date of last production \_\_\_\_\_ 19 \_\_\_\_  
Was permission obtained from the Conservation Division or its agents before plugging was commenced? Yes

Name of Conservation Agent who supervised plugging of this well Leo Massey  
Producing formation \_\_\_\_\_ Depth to top \_\_\_\_\_ Bottom \_\_\_\_\_ Total Depth of Well 3195 feet  
Show depth and thickness of all water, oil and gas formations.

OIL, GAS OR WATER RECORDS

CASING RECORD

FORMATION	CONTENT	FROM	TO	SIZE	PUT IN	PULLED OUT
				8 5/8"	213 K.B.	None

Describe in detail the manner in which the well was plugged, indicating where the mud fluid was placed and the method or methods used in introducing it into the hole. If cement or other plugs were used, state the character of same and depth placed, from \_\_\_\_\_ feet to \_\_\_\_\_ feet for each plug set.

1st Plug set @ 500' with 50 sacks  
2nd Plug set @ 185' with 25 sacks  
3rd Plug set @ 40' with 10 sacks  
Plug was down @ 4:30 p.m. March 15, 1976  
STATE PLUGGER: Leo Massey

MAR 23 1976  
MAR 23 1976  
Wichita, Kansas

Name of Plugging Contractor Abercrombie Drilling, Inc.  
Address 801 Union Center, Wichita, Kansas 67202

STATE OF Kansas COUNTY OF Sedgwick ss.  
Jerry A. Langrehr-Exec. V. P.

well, being first duly sworn on oath, says: That I have knowledge of the facts, statements, and matters herein contained and the log of the above-described well as filed and that the same are true and correct. So help me God.

(Signature) Jerry A. Langrehr  
801 Union Center, Wichita, KS 67202  
(Address)

SUBSCRIBED AND SWORN TO before me this 19th day of March, 19 76

My commission expires February 18, 1980  
Diane Steincamp  
Diane Steincamp Notary Public.

