


STATE OF KANSAS  
STATE CORPORATION COMMISSION

WELL PLUGGING RECORD

Give All Information Completely  
Make Required Affidavit  
Mail or Deliver Report to  
Conservation Division  
State Corporation Comm.  
245 North Water  
Wichita, KS 67202

Rooks \_\_\_\_\_ County. Sec. 35 Twp. 8 Rge. 18 E/W  
Location as "NE/CNW 1/4 SW 1/4" or footage from lines \_\_\_\_\_  
C-S 1/2-N 1/2-NE

Lease Owner Two Way Oil Co.  
Lease Name Dechant Well No. 5  
Office Address 1000 SW Second, Plainville, KS 67663  
Character of Well (Completed as Oil, Gas or Dry Hole) \_\_\_\_\_

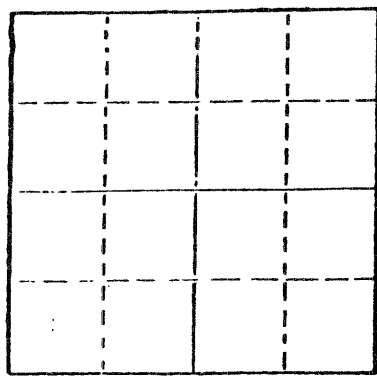

Locate well correctly on above  
Section Plat

Dry Hole  
Date Well completed 8-18 1977  
Application for plugging filed 8-18 1977  
Application for plugging approved 8-18 1977  
Plugging commenced 8-18 1977  
Plugging completed 8-18 1977  
Reason for abandonment of well or producing formation \_\_\_\_\_

Dry Hole  
If a producing well is abandoned, date of last production 19 \_\_\_\_\_

Was permission obtained from the Conservation Division or its agents before plugging was commenced? yes

Name of Conservation Agent who supervised plugging of this well Leo Massey  
Producing formation \_\_\_\_\_ Depth to top \_\_\_\_\_ Bottom \_\_\_\_\_ Total Depth of Well 2990  
Show depth and thickness of all water, oil and gas formations.

OIL, GAS OR WATER RECORDS

CASING RECORD

FORMATION	CONTENT	FROM	TO	SIZE	PUT IN	PULLED OUT
Surface Pipe		0'	170'	8 5/8"	170'	0'

Describe in detail the manner in which the well was plugged, indicating where the mud fluid was placed and the method or methods used in introducing it into the hold. If cement or other plugs were used, state the character of same and depth placed, from \_\_\_\_\_ feet to \_\_\_\_\_ feet for each plug set.

- 1st plug was set @ 550' w/50 sacks cement
- 2nd plug was set @ 180' w/25 sacks cement
- 3rd plug was set @ 40' w/10 sacks cement

RECEIVED  
STATE CORPORATION COMMISSION  
AUG 24 1977  
AUG 24 1977  
CONSERVATION DIVISION  
Wichita, Kansas

(If additional description is necessary, use BACK of this sheet)

Name of Plugging Contractor Dreiling Oil, Inc.

STATE OF KANSAS COUNTY OF ELLIS, ss.  
I, Joseph A. Hess, Sec. Treas of Drlg. Contrc. (employee of owner) or (owner or operator) of the above-described well, being first duly sworn on oath, says: That I have knowledge of the facts, statements, and matters herein contained and the log of the above-described well as filed and that the same are true and correct. So help me God.

(Signature) Joseph A. Hess  
JOSEPH A. HESS, HAYS, KS 67601  
(Address)

SUBSCRIBED AND SWORN TO before me this 23rd day of August, 19 77

My commission expires November 17, 1980.

Cecilia Basgall  
Cecilia Basgall Notary Public.

CECILIA BASGALL  
NOTARY PUBLIC  
Ellis County, Kansas

15-163. 20724-00-00

# DREILING OIL, INC.

Victoria, Kansas 67671

## WELL LOG

Company	Two Way Oil Co. 1000 SW Second Plainville, KS 67663	Sec.	35	Twp.	8	Rng.	18
Farm	Dechant No. 5	Location	C-S $\frac{1}{2}$ -N $\frac{1}{2}$ -NE				
Total Depth	2,990'	County	Rooks				
Comm.	8-15-77	Comp.	8-18-77	Elevation:	2027	K. B.	
Contractor	Dreiling Oil, Inc. Rt. #1 Victoria, KS 67671				2024	D. F.	
					2022	G. R.	
	Casing Record	Cement Record	Production:				
	170' - 8 5/8"	130 sacks cement	D & A				

### Figures Indicate Bottom of Formations

0'	70'	Post Rock
70'	292'	Shale
292'	1267'	Shale
1267'	1368'	Shale
1368'	1410'	Anhydrite
1410'	2044'	Shale
2044'	2666'	Lime & Shale
2666'	2925'	Shale
2925'	2990'	Lime
2990'	T.D.	

STATE OF KANSAS)  
                                   )ss  
 COUNTY OF ELLIS)

I, Joseph A. Hess, Secretary Treasurer of Dreiling Oil, Inc., upon oath states that the above and foregoing is a true and correct copy from the Daily Drilling Report from the Dechant #5.

Joseph A. Hess  
 JOSEPH A. HESS

Subscribed and sworn to before me this 23rd day of August, 1977.

Cecilia Basgall  
 Cecilia Basgall Notary Public

CECILIA BASGALL  
 NOTARY PUBLIC  
 STATE OF KANSAS

My appointment expires: November 17, 1980.

RECEIVED  
 STATE COMMISSIONER  
 AUG 24 1977  
 AUG 24, 1977  
 CONSERVATION DIVISION  
 Wichita, Kansas