


STATE OF KANSAS
STATE CORPORATION COMMISSION

Give All Information Completely
Make Required Affidavit
Mail or Deliver Report to:
Conservation Division
State Corporation Commission
211 No. Broadway
Wichita, Kansas

WELL PLUGGING RECORD

NORTH

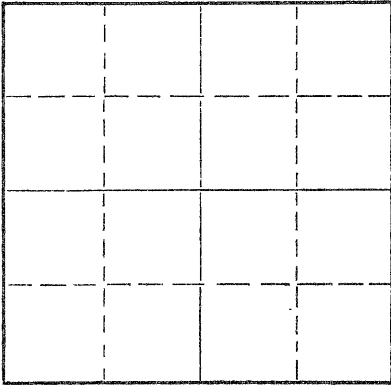

Locate well correctly on above
Section Plat

Rooks _____ County. Sec. 36 Twp. 8S Rge. (E)18 (W)
Location as "NE/CNW&SW" or footage from lines. NW SE SE
Lease Owner Dunne-Gardner Drilling Co., Inc.
Lease Name Toepffer Well No. A-1
Office Address 300 Schweiter Bldg., Wichita, Kansas
Character of Well (completed as Oil, Gas or Dry Hole) Dry Hole
Date well completed 10-25- 19 61
Application for plugging filed 10-25 19 61
Application for plugging approved 10-25 19 61
Plugging commenced 10-25 19 61
Plugging completed 10-25 19 61
Reason for abandonment of well or producing formation _____

If a producing well is abandoned, date of last production _____ 19 _____
Was permission obtained from the Conservation Division or its agents before plugging was commenced? yes

Name of Conservation Agent who supervised plugging of this well Eldon Petty
Producing formation _____ Depth to top _____ Bottom _____ Total Depth of Well 3465 Feet
Show depth and thickness of all water, oil and gas formations.

OIL, GAS OR WATER RECORDS

CASING RECORD

FORMATION	CONTENT	FROM	TO	SIZE	PUT IN	PULLED OUT
				8-5/8"	195'	None

Describe in detail the manner in which the well was plugged, indicating where the mud fluid was placed and the method or methods used in introducing it into the hole. If cement or other plugs were used, state the character of same and depth placed, from _____ feet to _____ feet for each plug set.

1/3 sack hulls and wooden plug at 540'
Mixed with 20 sacks cement thru drill pipe
1/3 sack hulls and wooden plug at 180'
Mixed with 20 sacks cement thru drill pipe
Mud to 35' and wooden plug at 35'
Mixed with 10 sacks cement.

NOV 20, 1961
CONSERVATION DIVISION
WICHITA, KANSAS

(If additional description is necessary, use BACK of this sheet)

Name of Plugging Contractor Chief Drilling Co., Inc.
Address P.O. Box 797, Great Bend, Kansas

STATE OF KANSAS, COUNTY OF BARTON, ss.

V. Richard Hoover, President, Chief Drlg. (employee of owner) or (owner or operator) of the above-described well, being first duly sworn on oath, says: That I have knowledge of the facts, statements, and matters herein contained and the log of the above-described well as filed and that the same are true and correct. So help me God.

(Signature) V. Richard Hoover
P.O. Box 797, Great Bend, Kansas
(Address)

SUBSCRIBED AND SWORN TO before me this 30th day of October, 19 61

My commission expires June 18, 1963

Dorothy B. John
Dorothy B. John
Notary Public.



WELL LOG

Dunne-Gardner Drilling Co., Inc.
300 Schweiter Bldg.
Wichita, Kansas

No. 1 Toepffer "A"
NW SE SE Sec. 36-8S-18W
Rooks County, Kansas

Contractor: Chief Drilling Co., Inc.
P.O. Box 797
Great Bend, Kansas

Commenced: 10-17-61
Completed: 10-25-61

CASING RECORD: 8-5/8" at 195' with 125 sacks HA-5 cement.

<u>FORMATION</u>	<u>FROM</u>	<u>TO</u>	<u>ELEVATION</u>
Shale & Post Rock	0	80	2007' Gr.
Shale	80	517	2009' D.F.
Sand	517	590	2012' K.B.
Shale & Sand	590	870	
Sand	870	1050	
Shale, Shells & Redbed	1050	1342	
Anhydrite	1342	1380	<u>FORMATION TOPS</u>
Shale & Shells	1380	1880	Anhydrite 1342 (drillers)
Shale & Lime Streaks	1880	1925	Heebner 3122
Lime & Shale	1925	2115	Toronto 3142
Lime	2115	2280	Lansing 3164
Lime & Shale Streaks	2280	2413	Base Kansas City 3387
Lime & Shale	2413	2550	Arbuckle 3420
Lime	2550	2795	
Lime & Shale	2795	3030	
Lime	3030	3395	
Lime & Shale	3395	3420	
Dolomite	3420	3465	
Total Depth	3465		

NOV 29 1961

STATE OF KANSAS, COUNTY OF BARTON) SS

I hereby certify that the above is true and correct copy of the Driller's Log of the well drilled in the NW SE SE Sec. 36-8S-18W, Rooks County, Kansas, to the best of my knowledge and belief.

CHIEF DRILLING CO., INC.

V. Richard Hoover
V. Richard Hoover, President

Subscribed and sworn to before me this 31st day of October, 1961.

Dorothy B. John
Dorothy B. John, Notary Public

My commission expires: June 18, 1963