

WELL PLUGGING RECORD

OR

FORMATION PLUGGING RECORD

Strike out upper line when reporting plugging off formations.

STATE OF KANSAS STATE CORPORATION COMMISSION

Give All Information Completely Make Required Affidavit Mail or Deliver Report to: Conservation Division State Corporation Commission 800 Biting Building Wichita, Kansas

Rooks County, Sec. 36 Twp. 8 Rge. 18 (W)

Location as "NE 1/4 NW 1/4 SW 1/4" or footage from lines CEL NE 1/4 NW 1/4

Lease Owner Sharon Drilling Company, Inc.

Lease Name Maddy Well No.

Office Address 352N. Broadway, Wichita, Kansas

Character of Well (completed as Oil, Gas or Dry Hole)

Date well completed May 12 19 41

Application for plugging filed April 4 19 43

Application for plugging approved April 4 19 43


Plugging commenced April 4 19 43

Plugging completed April 8 19 43

Reason for abandonment of well or producing formation Depleted

If a producing well is abandoned, date of last production June 19 42

Was permission obtained from the Conservation Division or its agents before plugging was commenced? Yes

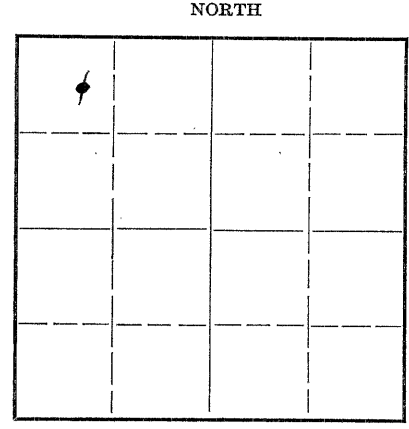

Locate well correctly on above Section Plat

Name of Conservation Agent who supervised plugging of this well C. T. Alexander P. B.

Producing formation Kansas City Lime Depth to top 3158 Bottom 3436 Total Depth of Well 3438 Feet

Show depth and thickness of all water, oil and gas formations.

OIL, GAS OR WATER RECORDS

CASING RECORD

Table with 7 columns: Formation, Content, From, To, Size, Put In, Pulled Out. Row 1: Kansas City Lime, Oil, 3367, 3401, 8 5/8, 60, None. Row 2: Kansas City Lime, Oil, 3367, 3401, 5 1/2, 3438, 2721'

Describe in detail the manner in which the well was plugged, indicating where the mud fluid was placed and the method or methods used in introducing it into the hold. If cement or other plugs were used, state the character of same and depth placed, from feet to feet for each plug set.

- Cement 3438 - 3390
Mud 3390 - 3320
Cement 3320 - 3304
Mud 3304 - 250
Bridged Hole 250
Cement 250 - 224
Mud 224 - 26
Cement 26 - 0

PLUGGING FILE EX 36 T 8 R 18 W PAGE 69 LINE 16

Apr 28, 1943

(If additional description is necessary, use BACK of this sheet)

Correspondence regarding this well should be addressed to Sharon Drilling Company, Inc., 352 North Broadway, Wichita, Kansas

STATE OF Kansas COUNTY OF Sedgwick M. S. Davis (employee of owner) of the above-described well,

being first duly sworn on oath, says: That I have knowledge of the facts, statements, and matters herein contained and the log of the above-described well as filed and that the same are true and correct. So help me God.

(Signature) M. S. Davis

Wichita, Kansas (Address)

SUBSCRIBED AND SWORN TO before me this 27th day of April 19 43

My commission expires May 4, 1943

Emma Schlowe Notary Public

OFFICES OF
SHARON DRILLING COMPANY, INC.
352 NORTH BROADWAY
WICHITA, KANSAS

April 27, 1943

State Corporation Commission,
Conservation Division,
800 Bitting Bldg.,
Wichita, Kansas

Gentlemen:

Enclosed is Material Report and Well
Plugging Record covering our Maddy Lease, GEL NE $\frac{1}{4}$
NW $\frac{1}{4}$ Sec. 36-8-18W., Rooks County, Kansas, which has
been abandoned.

Yours truly,

SHARON DRILLING COMPANY, INC.;

By M. S. Davis

MSD:es

encl. 2

PLUGGING
FILE 36 8-18W
BOOK PAGE 69 LINE 16

STATE CORPORATION
COMMISSION
APR 28 1943
WICHITA, KANSAS

15-163-03927-00-00

April 14, 1943

Sharon Drilling Company
352 North Broadway
Wichita, Kansas

Dear Sirs:

Attached hereto find material report form to be executed by you on your No. 1 Maddy "A" well located in the CNE of the NE of the NW of Section 36, Township 8, Range 18 West, Rocks County, Kansas.

This new form has been requested by the Federal Government and must be mailed to this office within five days after plugging has been completed. Will you please give this matter your immediate attention.

Very truly yours,

STATE CORPORATION COMMISSION
CONSERVATION DIVISION

By: _____
J. P. ROBERTS


Encl.

MATERIAL REPORT AND PLUGGING RECORD

Mail To: STATE CORPORATION COMMISSION
Conservation Division
800 Bitting Building
Wichita, Kansas

NOTICE: All questions on this form must be answered.

Company Operating..... Sharon Drilling Company, Inc.
Office Address..... 352 North Broadway, Wichita, Kansas

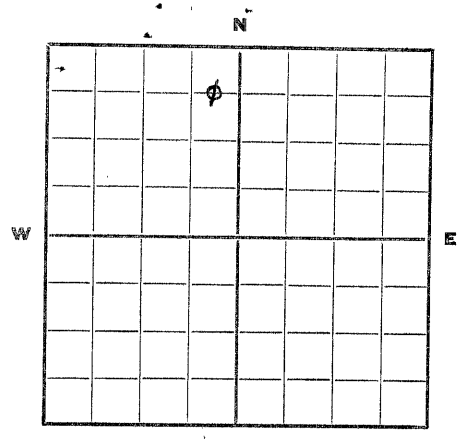

Locate well correctly.

County..... Rooks Sec. 36 Twp. 8 Rge. 18W
Farm Name..... Maddy Well No. 1 Field. Dopita
Well Location..... Gen EL NE NW 1/4
Name of Producing Sand..... Lansing Kansas City Total Depth. 3438
Commenced Plugging..... April 4 Finished..... April 8, 1943

DAILY AVERAGE PRODUCTION:

Initial Production: Oil..... 105 Bbls. Gas..... None Water..... 15 Bbls.
Production when Plugged: Oil..... 2 1/2 Bbls. Gas..... None Water..... 125 Bbls.

Estimated Total Remaining Reserves Attributable to Well at Time Abandoned..... None

INFORMATION ON MATERIALS RECLAIMED FROM WELL CASING, TUBING AND ROD DATA

Description	Size	Recovered		Junk		Reusable		Disposition Made Or To Be Made Of Usable Material
		Ft.	Tons	Ft.	Tons	Ft.	Tons	
Casing	5 1/2	2721	19.04			2721	19.04	To be used in future wells
Tubing	2"EUE	3376	7.93			3376	7.93	To be used in future wells and replacements.
Rods	5/8"	3274	1.80			3274	1.80	" " "

APR 28 1943

SURFACE EQUIPMENT

Quantity	Description	*Condition	Est. Tons	Disposition Made Or To Be Made Of Reclaimed Material
1	14 H. P., Pumping Unit	Usuable	3.8	To be used on future well.
2	Tanks	Poor	2.5	" "
641' 6"	2" Line Pipe	Usuable	1.2	" "
544' 1"	3" Line Pipe	"	2.0	" "

* Usable, Usable with minor repairs, or junk.

Date: April 27, 1943

Signed: M. L. Davis Chief Clerk
(For Operating Co.—Title)

DRILLING
 36 8 18W
 69 LINE 16

Sharon #1 Maddy

Geological Taps

Anhydrite	1300-1346
Ft. Riley	2045
Base Florence	2142
Topeka	2922
Lansing	3158
Arbuckle	3436

36 8 18W
69 16

June 18th, 1942.

Mr. Wirt Franklin
U.S. Dept. of the Interior
Office of Petroleum Coordinator for
National Defense
Suite 1336
120 South LaSalle
Chicago, Illinois

Dear Sir:

In compliance with requirements of
Title 32, Chapter XIII - OPG, Recommendation 47,
Part 1503 - Production, you will please find enclosed
herewith OPG Form 63, being our application for the
abandonment and plugging of our Maddy "A" #1 well in
the Depita Pool, Rocks County, Kansas.

Respectfully yours,

SHARON DRILLING COMPANY, INC.

By *AScates*

BSCates/m

Encl.

FILE	36	8	18W
DATE	69		16