


STATE OF KANSAS
STATE CORPORATION COMMISSION

Form CP-4

Give All Information Completely
Make Required Affidavit
Mail or Deliver Report to:
Conservation Division
State Corporation Commission
212 No. Market
Wichita, Kansas

WELL PLUGGING RECORD

ROOKS County. Sec. 36 Twp. 8S Rge. 18 (E) (W)
Location as "NE/CNW*SW*" or footage from lines NW SE NW
Lease Owner PETROLEUM, INC.,
Lease Name WEIGEL "C" Well No. 1
Office Address R.R. #2, GREAT BEND, KANSAS
Character of Well (completed as Oil, Gas or Dry Hole) DRY HOLE
Date well completed APRIL 10, 19 67
Application for plugging filed APRIL 10 19 67
Application for plugging approved APRIL 10 19 67
Plugging commenced APRIL 10 19 67
Plugging completed APRIL 10 19 67
Reason for abandonment of well or producing formation NO PRODUCIBLE ZONE

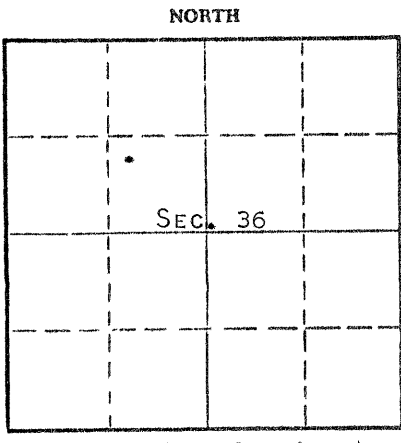

Locate well correctly on above Section Plat

If a producing well is abandoned, date of last production NONE 19
Was permission obtained from the Conservation Division or its agents before plugging was commenced? YES

Name of Conservation Agent who supervised plugging of this well LEO F. MASSEY
Producing formation _____ Depth to top _____ Bottom _____ Total Depth of Well 3177 Feet
Show depth and thickness of all water, oil and gas formations.

OIL, GAS OR WATER RECORDS CASING RECORD

FORMATION	CONTENT	FROM	TO	SIZE	PUT IN	PULLED OUT
				8-5/8	217	NONE

Describe in detail the manner in which the well was plugged, indicating where the mud fluid was placed and the method or methods used in introducing it into the hole. If cement or other plugs were used, state the character of same and depth placed, from _____ feet to _____ feet for each plug set.

MUD TO 540', FOLLOWED BY WOODEN PLUG, PLACED 20 SACKS CEMENT ON TOP OF PLUG.
MUD TO 210', FOLLOWED BY WOODEN PLUG, PLACED 20 SACKS CEMENT ON TOP OF PLUG.
MUD TO 40', FOLLOWED BY WOODEN PLUG, PLACED 1/4 SACK HULLS & 8 SACKS CEMENT ON TOP OF PLUG TO BASE OF WELL CELLAR.

RECEIVED
STATE CORPORATION COMMISSION
APR 19 1967
APR 19 1967
CONSERVATION DIVISION
WICHITA, KANSAS

(If additional description is necessary, use BACK of this sheet)
Name of Plugging Contractor GARVEY DRILLING COMPANY
Address R.R. #2, GREAT BEND, KANSAS

STATE OF KANSAS, COUNTY OF BARTON, ss.
MONTE CHADD (employee of owner) or (owner or operator) of the above-described well, being first duly sworn on oath, says: That I have knowledge of the facts, statements, and matters herein contained and the log of the above-described well as filed and that the same are true and correct. So help me God. MONTE CHADD DIST. PROD. SUPT.

(Signature) Monte Chadd
R.R. #2, GREAT BEND, KANSAS (Address)

SUBSCRIBED AND SWORN to before me this 18 day of APRIL, 19 67

Richard H. Dunks
Notary Public.

My commission expires MAY 28, 1969

WELL LOG

COMPANY Petroleum, Inc.

SEC. 36 T. 8S R. 18W

FARM Weigel

NO. C-1

LOC. NW SE NW


TOTAL DEPTH 3177'

COUNTY Rooks

COMM. 4-6-67

COMP. 4-10-67

CONTRACTOR Garvey Drilling Company

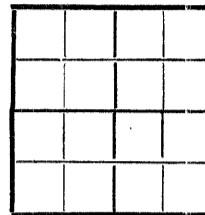

CASING 8 5/8" @ 217' w/175 SX

ELEVATION 2002' KB

PRODUCTION D & A

FIGURES INDICATE BOTTOM OF FORMATIONS

- 40' Top Soil and Post Rock
- 217' Shale
- 970' Shale and Sand Streaks
- 1110' "D" Sand
- 1120' Shale
- 1385' Shale and Shells
- 1420' Anhydrite
- 1713' Shale
- 2050' Shale and Lime
- 2605' Lime and Shale
- 3070' Shale with Lime
- 3177' Lime
- 3177' RTD

RECEIVED
 STATE CORPORATION COMMISSION
 APR 19 1967
 APR 19 1967
 CONSERVATION DIVISION
 Wichita, Kansas

State of Kansas }
 County of Barton } SS

I, Sam N. Stephens of Garvey Drilling Company

upon oath state the above and foregoing is a true and correct copy of the log of the Weigel C-1 well.

Sam N. Stephens

Subscribed and sworn to before me this 15th day of April 19 67

My Commission Expires: November 5th, 1969

Richard Hoys
 NOTARY PUBLIC