

15-163-00005-00-00

STATE OF KANSAS
STATE CORPORATION COMMISSION


WELL PLUGGING RECORD

Give All Information Completely
Make Required Affidavit
Mail or Deliver Report to:
Conservation Division
State Corporation Commission
800 Bitting Building
Wichita, Kansas

OR
FORMATION PLUGGING RECORD

Strike out upper line
when reporting plug-
ging off formations.

NORTH

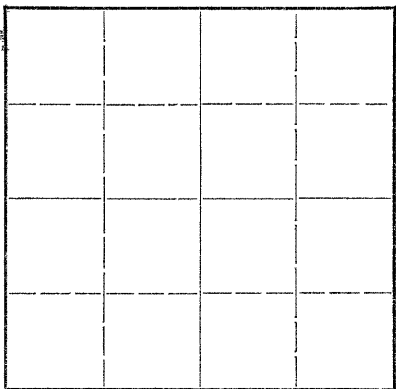

Locate well correctly on above
Section Plat

Rocks..... County. Sec. 6 Twp. 3S Rge. 19W (E)..... (W)
Location as "NE 1/4 NW 1/4 SW 1/4" or footage from lines. NE NE NW
Lease Owner. Anderson-Prichard Oil Corporation
Lease Name. McCormick Well No. 1
Office Address. Oklahoma City, Oklahoma
Character of Well (completed as Oil, Gas or Dry Hole). Dry hole
Date well completed. September 20, 1947
Application for plugging filed. (verbal) September 20, 1947
Application for plugging approved. (verbal) September 20, 1947
Plugging commenced. September 20, 1947
Plugging completed. September 20, 1947
Reason for abandonment of well or producing formation. Dry hole

If a producing well is abandoned, date of last production..... 19.....
Was permission obtained from the Conservation Division or its agents before plugging was com-
menced? Yes

Name of Conservation Agent who supervised plugging of this well. C. D. Stough
Producing formation..... Depth to top..... Bottom..... Total Depth of Well 3425 Feet
Show depth and thickness of all water, oil and gas formations.

OIL, GAS OR WATER RECORDS

CASING RECORD

Formation	Content	From	To	Size	Put In	Pulled Out
				9 5/8	1406	None

Describe in detail the manner in which the well was plugged, indicating where the mud fluid was placed and the method or methods used in introducing it into the hold. If cement or other plugs were used, state the character of same and depth placed, from..... feet to..... feet for each plug set.

Filled with heavy mud from bottom to 1406 feet.

Bridged hole with Halliburton plug and plugged with 15 sacks of cement. Cemented through drill pipe. Filled with heavy mud to 100 feet. Bridged hole with wooden plug at 100 feet and plugged with 10 sacks of cement. Cemented through drill pipe.

Filled with heavy mud to 10 feet. Bridged hole with wooden plug and plugged with 5 sacks of cement.

(If additional description is necessary, use BACK of this sheet)

Correspondence regarding this well should be addressed to Anderson-Prichard Oil Corporation
Address. Oklahoma City, Oklahoma

9-24-47

STATE OF KANSAS, COUNTY OF SEDGWICK, ss.

W. N. Smith (employee of owner) or (owner or operator) of the above-described well, being first duly sworn on oath, says: That I have knowledge of the facts, statements and matters herein contained and the log of the above-described well as filed and that the same are true and correct. So help me God.

(Signature)

Wichita, Kansas

(Address)

SUBSCRIBED AND SWORN to before me this 22nd day of September, 1947.

My commission expires January 21, 1950.

Notary Public.

21-6858-RS 2-47-6M

PLUGGING
FILE SEC 6 T 8 R 19W
BOOK PAGE 135 LINE 13

15-163-00005-00-00

DETAILED LOG OF FORMATIONS ENCOUNTERED IN





FORMATION	FROM	TO
Sand Clay & Sack	0	70
Shale & Shells	70	320
Shale	320	430
Sand	430	525
Shale & Shells	525	1257
Anhydrite	1257	1420
Red Sand	1420	1700
Shale & Shells	1700	1915
Shale	1915	1945
Shale & Linn	1945	2100
Linn	2100	2200
Shale & Linn	2200	2400
Linn	2400	2500
Linn & Shale	2500	2600
Linn	2600	2650
Shale & Linn	2650	2770
Linn	2770	2820
S. W. 1/4	2820	2820

Net 1420' of 2-3/8" Eng.
 at 1420' and cemented w/
 200 sacks cement.

Contractor - Transit Corporation
 1200 Young
 Oklahoma City, Okla.

I hereby certify the foregoing to be a true and correct driller's log of the formations encountered in the above well.

PLUGGING
 FILE SEC. 6-8-19W
 BOOK PAGE 135, LINE 13

[Signature]
 10-11-47

OCT 11 1947

Certified to balance to this 9th day of October, 1947

[Signature]
 District Office

by Commissioner of Mines *[Signature]* 10-11-47