


STATE OF KANSAS
STATE CORPORATION COMMISSION
200 Colorado Derby Bldg.
Wichita, Kansas 67202

WELL PLUGGING RECORD

Give All Information Completely
Make Required Affidavit

COUNTY Rooks SEC. 31 TWP. 8s RGE. 17W
Location as in quarters or footage from lines:
C of NE SW NW

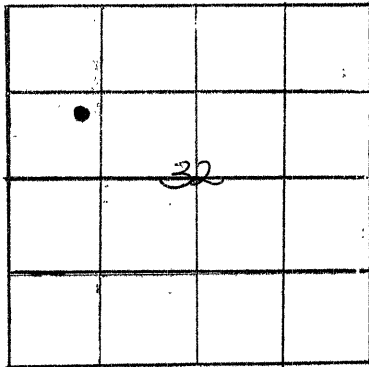

Locate Well
correctly on above
Section Platt.

Lease Owner The Two-Way Oil Company
Lease Name Stamper Well No. 2
Office Address 407 South Main Plainville, Kansas 67663
Character of Well (Completed as Oil, Gas or Dry Hole): dry
Date Well Completed 9-16-82
Application for plugging filed July 18-1982
Plugging commenced July 22, 1982
Plugging completed July 22, 1982
Reason for abandonment of well or producing formation dry hole

Was permission obtained from the Conservation Division or it's
Agent's before plugging was commenced? yes

Name of Conservation Agent who supervised plugging of this well Dennis Hamel

Producing formation _____ Depth to top _____ bottom _____ T.D. 3470

Show depth and thickness of all water, oil and gas formations.

OIL, GAS OR WATER RECORDS

Casing Record

Formation	Content	From	To	Size	Put in	Pulled Out
Kansas City	water	3121	3350	5 1/2	3469	0
Arbuckle	water	3391	3428	8 5/5	170	0

Describe in detail the manner in which the well was plugged, indicating where the mud fluid was placed and the method or methods used in introducing it into the hold. If cement or other plugs were used, state the character of same and depth placed, from _____ feet to _____ feet for each plug set. Pumped down 5 1/2 casing-50 sks cement and 2 sks hulls, followed by 18 sks gel--pumped 100 sks cement with 3 sks hulls. well on vaccuum.

50 sks cement with 2 1/2 sks hulls pumped down 8 5/5 casing.
1/2 sk hulls mixed with cement pumped down 5 1/2 waited 1 hr.
pumped 25 sks cement in 5 1/2 casing.
Pumped 10 sks cement in 8 5/8 casing.


(If additional description is necessary, use BACK of this sheet)

Name of Plugging Contractor _____

STATE OF Kansas COUNTY OF Rooks, ss.
Thomas E. Brown (~~employee of owner~~) or (owner and operator) of the
above-described well, being first duly sworn on oath, says: That I have knowledge of the
facts, statements, and matters herein contained and the log of the above-described well as
filed and that the same are true and correct. So help me God.

(Signature) Thomas E. Brown
407 S. Main Plainville, Ks.
(Address) 67663

SUBSCRIBED AND SWORN TO before me this 18th day of October, 1982

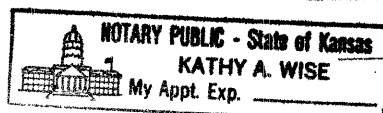

My Commission expires: _____

Kathy A. Wise
Notary Public.
STATE CORPORATION COMMISSION

OCT 20 1982
OCT 20 1982
CONSERVATION DIVISION
Wichita, Kansas