


STATE OF KANSAS
STATE CORPORATION COMMISSION

Give All Information Completely
Make Required Affidavit
Mail or Deliver Report to:
Conservation Division
State Corporation Commission
211 No. Broadway
Wichita, Kansas

15-163-19077-00-00
WELL PLUGGING RECORD

NORTH

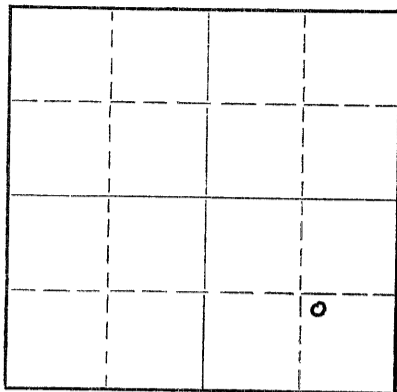

Locate well correctly on above
Section Plat

Rooks County. Sec. 36 Twp. 8S Rge. 17 (E) W (W)
Location as "NE/CNW%SW%" or footage from lines NW SE SE
Lease Owner Arnell Company
Lease Name McComb Well No. 1
Office Address 533 Petroleum Building, Wichita, Kansas
Character of Well (completed as Oil, Gas or Dry Hole) Dry hole
Date well completed 4-24 1957
Application for plugging filed 4-24 1957
Application for plugging approved 4-24 1957
Plugging commenced 4-24 1957
Plugging completed 4-24 1957
Reason for abandonment of well or producing formation Dry hole

If a producing well is abandoned, date of last production 19____
Was permission obtained from the Conservation Division or its agents before plugging was commenced? Yes

Name of Conservation Agent who supervised plugging of this well Eldon Petty
Producing formation _____ Depth to top _____ Bottom _____ Total Depth of Well 3440 Feet
Show depth and thickness of all water, oil and gas formations.

OIL, GAS OR WATER RECORDS

CASING RECORD

| FORMATION | CONTENT | FROM | TO | SIZE | PUT IN | PULLED OUT |
|-----------|---------|------|----|--------|--------|------------|
| | | | | 8 5/8" | 224' | |
| | | | | | | |
| | | | | | | |
Describe in detail the manner in which the well was plugged, indicating where the mud fluid was placed and the method or methods used in introducing it into the hole. If cement or other plugs were used, state the character of same and depth placed, from _____ feet to _____ feet for each plug set.

Filled hole with heavy mud to 220'. Set Bottom plug at 220' with 1 sack Hulls and 15 sacks bulk cement. Filled hole with heavy mud to 40'. Set top plug at 40' with 1/2 sack hulls and 10 sacks cement.

(If additional description is necessary, use BACK of this sheet)

Name of Plugging Contractor Kan-Tex Drillers, Inc.
Address 802 Union National Building, Wichita 2, Kansas

STATE OF Kansas, COUNTY OF Sedgwick, ss.
Harvey E. Nightingale (employee of owner) or (owner or operator) of the above-described well, being first duly sworn on oath, says: That I have knowledge of the facts, statements, and matters herein contained and the log of the above-described well as filed and that the same are true and correct. So help me God.

(Signature) Harvey E. Nightingale
802 Union National Building, Wichita, Kansas
(Address)

SUBSCRIBED AND SWORN TO before me this 26 day of April, 1957

My commission expires November 8, 1960
Frances E. Kroenke Notary Public.

PLUGGING
FILE SEC. 36 T. 8 R. 17W
BOOK PAGE 9 LINE 26

RECEIVED
MAY 1 1957
5/9/57

15-163-19027-00-00

DRILLERS' LOG

No. 1 McComb
NW SE SE of Section 36-8S-17W
Rooks County, Kansas

| FROM | TO | |
|------|------|--------------------------|
| 0 | 50 | Part rock |
| 50 | 224 | Shale |
| 224 | 775 | Shale, shells, sand |
| 775 | 955 | Sand |
| 955 | 1250 | Shale, Red Bed |
| 1250 | 1280 | Anhydrite |
| 1280 | 1470 | Shale, shells |
| 1470 | 1665 | Lime, shells, shale |
| 1665 | 1765 | Shale, lime |
| 1765 | 1885 | Shale, lime, pyrite |
| 1885 | 2185 | Lime, shale |
| 2185 | 2210 | Shale, lime |
| 2210 | 2503 | Lime, shale |
| 2503 | 2825 | Shale, lime |
| 2825 | 2905 | Lime, shale |
| 2905 | 2949 | Shale, lime |
| 2949 | 3374 | Lime |
| 3374 | 3391 | Conglomerate |
| 3391 | 3440 | Lime |
| 3440 | | Rotary Total Depth D & A |

COMMENCED: 4-12-1957

COMPLETED: 4-24-1957

CASING RECORD:

Set 8 5/8" surface casing
at 224' with 135 sacks
bulk cement, 1 % Calcium
Chloride.

STATE OF KANSAS)
) S S
COUNTY OF SEDGWICK)

I hereby affirm that the above and foregoing is a true and correct copy of the formations encountered on the No. 1 McComb, NW SE SE of Section 36-8S-17W, Rooks County, Kansas, as reflected by the daily drilling reports.

KAN-TEX DRILLERS, INC.

By: Harvey E. Nightingale
Harvey E. Nightingale

Subscribed and sworn to before me this 26 day of April 1957

Frances E. Koenig
Notary Public

My Commission Expires: November 8, 1960

PLUGGING
FILE SEC 36 T. 8 17W
BOOK PAGE 9 LINE 26

RECEIVED
STATE CORPORATION COMMISSION

MAY 9 - 1957

CONSERVATION DIVISION
Wichita, Kansas

5/2/57