


STATE OF KANSAS
STATE CORPORATION COMMISSION

WELL PLUGGING RECORD

Give All Information Completely
Make Required Affidavit
Mail or Deliver Report to
Conservation Division
State Corporation Comm.
245 North Water
Wichita, KS 67202

Rooks County, Sec. 15 Twp. 8 Rge. 18 X/W
Location as "NE/CNW 1/4 SW 1/4" or footage from lines
C W/2 NE
Lease Owner Kenny Brown Enterprises
Lease Name Maddy Well No. 1
Office Address P.O. Drawer 340, Plainville, KS 67663
Character of Well (Completed as Oil, Gas or Dry Hole)

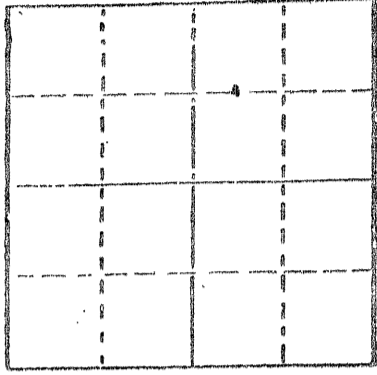

Locate well correctly on above Section Plat

Dry Hole
Date Well completed 10-17-1982
Application for plugging filed 10-17-1982
Application for plugging approved 10-17-1982
Plugging commenced 10-17-1982
Plugging completed 10-17-1982
Reason for abandonment of well or producing formation
Dry Hole

If a producing well is abandoned, date of last production 19

Was permission obtained from the Conservation Division or its agents before plugging was commenced? Yes

Name of Conservation Agent who supervised plugging of this well Marion Schmidt
Producing formation Depth to top Bottom Total Depth of Well 3245'
Show depth and thickness of all water, oil and gas formations.

OIL, GAS OR WATER RECORDS

CASING RECORD

FORMATION	CONTENT	FROM	TO	SIZE	PUT IN	PULLED OUT
				8 5/8"	179'	-0-

Describe in detail the manner in which the well was plugged, indicating where the mud fluid was placed and the method or methods used in introducing it into the hold. If cement or other plugs were used, state the character of same and depth placed, from feet to feet for each plug set.

- 1st plug was set at 1350' with 20 sacks cement
- 2nd plug was set at 780' with 100 sacks cement
- 3rd plug was set at 240' with 40 sacks cement
- 4th plug was set at 40' with 10 sacks cement
- 10 sacks rat hole
- 10 sacks mouse hole

(If additional description is necessary, use BACK of this sheet)


Name of Plugging Contractor Dreiling Oil, Inc., Victoria, KS 67671

STATE OF Kansas COUNTY OF Rooks ss.
(employee of owner) or (owner or operator)
of the above-described well, being first duly sworn on oath, says: That I have knowledge of the facts, statements, and matters herein contained and the log of the above-described well as filed and that the same are true and correct. So help me God.

(Signature) Kenneth O Brown

(Address)

SUBSCRIBED AND SWORN TO before me this 22 day of October, 1982

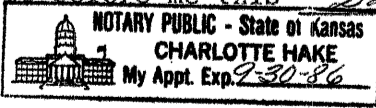

Charlotte Hake Notary Public.

My commission expires

OCT 25 1982
10/25/82
CONSERVATION DIVISION
Wichita, Kansas