

15-163-20477-00-00


STATE OF KANSAS
STATE CORPORATION COMMISSION

Form CP-4

Give All Information Completely
Make Required Affidavit
Mail or Deliver Report to:
Conservation Division
State Corporation Commission
P. O. Box 17027
Wichita, Kansas 67217
NORTH

WELL PLUGGING RECORD

ROOKS County. Sec. 22 Twp. 8S Rge. (E) 19 (W)
Location as "NE/CNW&SW" or footage from lines SW SE SE
Lease Owner A SCOTT RITCHIE
Lease Name KELLOGG Well No. 1
Office Address 412 UNION CENTER BUILDING
Character of Well (completed as Oil, Gas or Dry Hole) DRY HOLE
Date well completed DECEMBER 22 19 72
Application for plugging filed DECEMBER 22 19 72
Application for plugging approved DECEMBER 22 19 72
Plugging commenced DECEMBER 22 19 72
Plugging completed DECEMBER 22 19 72
Reason for abandonment of well or producing formation TOO LOW STRUCTURALLY

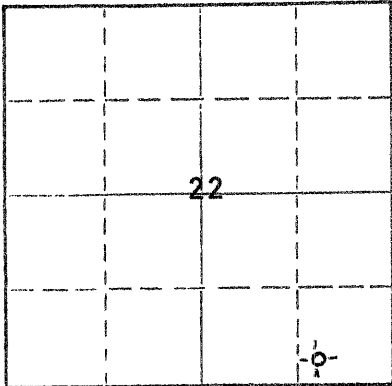

Locate well correctly on above
Section Plat

If a producing well is abandoned, date of last production _____ 19 ____
Was permission obtained from the Conservation Division or its agents before plugging was commenced? YES

Name of Conservation Agent who supervised plugging of this well LEO F MASSEY, HAYS, KANSAS
Producing formation _____ Depth to top _____ Bottom _____ Total Depth of Well 3402 Feet
Show depth and thickness of all water, oil and gas formations.

OIL, GAS OR WATER RECORDS

CASING RECORD

FORMATION	CONTENT	FROM	TO	SIZE	PUT IN	PULLED OUT
				8 5/8"	208.03	NONE

Describe in detail the manner in which the well was plugged, indicating where the mud fluid was placed and the method or methods used in introducing it into the hole. If cement or other plugs were used, state the character of same and depth placed, from _____ feet to _____ feet for each plug set.

FILLED WITH HEAVY MUD TO 600'. SET PLUG. PUT IN 70 SXS CEMENT. FILLED WITH HEAVY MUD TO 210'. SET PLUG. PUT IN 20 SXS CEMENT. FILLED WITH HEAVY MUD UP TO 40'. SET PLUG. FILLED TO TOP WITH SOLID BRIDGE, 1 SX HULLS & 10 SXS CEMENT.

RECEIVED
STATE CORPORATION COMMISSION
JAN 18 1973
CONSERVATION DIVISION
Wichita, Kansas
1/18/73

(If additional description is necessary, use BACK of this sheet)
Name of Plugging Contractor C-G DRILLING CO.
Address 1107 UNION NATIONAL BUILDING, WICHITA, KANSAS 67202

STATE OF KANSAS COUNTY OF SEDGWICK, ss.
G. F. GALLOWAY (employee of owner) or (owner or operator) of the above-described well, being first duly sworn on oath, says: That I have knowledge of the facts, statements and matters herein contained and the log of the above-described well as filed and that the same are true and correct. So help me God.

(Signature) G. F. Galloway
1107 Union National Building (Address)



Subscribed and sworn to before me this 22nd day of December, 19 72
Phyllis Buchanan
Notary Public.

15-163-20477-00-00

WELL LOG

OPERATOR: A. SCOTT RITCHIE

WELL NAME: KELLOGG #1 LOCATION: SW SE SE SEC 22-8S-19W

COUNTY: ROOKS STATE: KANSAS

WELL COMMENCED: DEC 12, 1972 WELL COMPLETED: DEC 22, 1972

ELEVATION: 1928 KB TOTAL DEPTH: 3402

PRODUCTION: DRY AND ABANDONED RIG NO: 1

CASING - 8-5/8": SET @ 208.03 (5 JTS) 28# USED W/135 SX CEMENT
+ 2% GEL & 3% CA CL

5-1/2":

ALL MEASUREMENTS TAKEN FROM THE TOP OF ROTARY BUSHING:

FROM	TO	FORMATION	DEVIATION FROM VERTICAL	REMARKS:
0	490	SHALE		
490	640	SAND		
640	820	SHALE & SAND		
820	970	SAND		
970	1000	SHALE & SHELLS		
1000	1030	SAND		
1030	1090	SHALE		
1090	1344	SHALE & RED BED		
1344	1377	ANHYDRITE		
1377	1810	RED BED & SHALE	2° @ 1519'	
1810	3125	SHALE & LIME	1° @ 2175'	DST #1' 3070'-3125'
3125	3365	LIME	1° @ 3037'	DST #2 3159'-3192'
3365	3402	ARBUCKLE LIME		DST #3 3189'-3222'
3402		RTD		DST #4 3231'-3286'
				DST #5 3362'-3370'
				DST #6 3370'-3402'

RECEIVED
STATE CORPORATION COMMISSION
JAN 18 1973
CONSERVATION DIVISION
Wichita, Kansas

STATE OF KANSAS)
COUNTY OF SEDGWICK) SS:

The undersigned hereby certifies that to the best of his knowledge and belief, the above facts are true and correct.

C-G DRILLING CO.

By G. F. Galloway

G. F. Galloway

SUBSCRIBED AND SWORN TO, BEFORE ME, This 26th day of December, 1972.

MY COMM. EXP. DEC. 7, 1975

Phyllis Buchanan
PHYLLIS BUCHANAN - NOTARY PUBLIC

