


STATE OF KANSAS  
STATE CORPORATION COMMISSION

WELL PLUGGING RECORD

Give All Information Completely  
Make Required Affidavit  
File or Deliver Report to  
Conservation Division  
State Corporation Comm.  
245 North Water  
Wichita, KS 67202

Rocks \_\_\_\_\_ County. Sec. 21 Twp. 8S Rge. 19 E/W  
Location as "NE/CNW/SW" or footage from lines \_\_\_\_\_  
NE SW SE  
Lease Owner JEDCO  
Lease Name Veverka Well No. #1  
Office Address P.O. Box 1097, 124 S. Main Hesston, KS 67062  
Character of Well (Completed as Oil, Gas or Dry Hole) \_\_\_\_\_  
Dry Hole  
Date Well completed September 5, 1980 19  
Application for plugging filed September 5, 1980 19  
Application for plugging approved September 5, 1980 19  
Plugging commenced September 5, 1980 19  
Plugging completed September 5, 1980 19  
Reason for abandonment of well or producing formation  
No Commercial Production  
If a producing well is abandoned, date of last production \_\_\_\_\_ 19

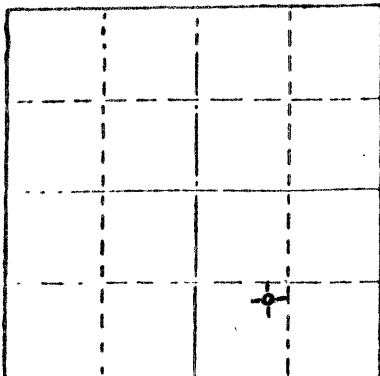

Locate well correctly on above Section Plot

Was permission obtained from the Conservation Division or its agents before plugging was commenced? Yes  
Name of Conservation Agent who supervised plugging of this well Marion Schmidt  
Producing formation \_\_\_\_\_ Depth to top \_\_\_\_\_ Bottom \_\_\_\_\_ Total Depth of Well \_\_\_\_\_  
Show depth and thickness of all water, oil and gas formations.

OIL, GAS OR WATER RECORDS

CASING RECORD

FORMATION	CONTENT	FROM	TO	SIZE	PUT IN	PULLED OUT
surface casing	common	0	205.61	8 5/8	205.61	0

Describe in detail the manner in which the well was plugged, indicating where the mud fluid was placed and the method or methods used in introducing it into the hold. If cement or other plugs were used, state the character of same and depth placed, from \_\_\_\_\_ feet to \_\_\_\_\_ feet for each plug set.

Plug #1 @ 700' with 70 sxs  
Plug #2 @ 180' with 25 sxs  
Plug #3 @ 40' solid bridge 10 sxs  
50-50 poz 6% gel 5 sxs in rathole  
Completed at 6:30 a.m.

RECEIVED  
STATE CORPORATION COMMISSION  
OCT 14 1980  
OCT 14 1980  
CONSERVATION DIVISION  
Wichita, Kansas

(If additional description is necessary, use BACK of this sheet)  
Name of Plugging Contractor Pioneer Drilling Company, Inc.  
308 West Mill Street Plainville, Kansas 67663

X STATE OF Kansas COUNTY OF Harvey, ss.  
(employee of owner) or (owner or operator)

I, the above-described well, being first duly sworn on oath, says: That I have knowledge of the facts, statements, and matters herein contained and the log of the above-described well filed and that the same are true and correct. So help me God.

(Signature) Robert E. Yoder  
Box 1097, Hesston, KS  
(Address)

SUBSCRIBED AND SWORN TO before me this 13 day of October, 1980

BECKY ROLAND  
STATE NOTARY PUBLIC  
Harvey County, Kansas  
My Appointment Expires:  
12-19-83

Becky Roland  
Notary Public.

My commission expires \_\_\_\_\_

WELL LOG

OPERATOR: JEDCO

WELL NAME: Veverka #1 LOCATION: NE SW SE 21-8S-19W

COUNTY: Rooks STATE: Kansas

WELL COMMENCED: August 27, 1980 WELL COMPLETED: September 5, 1980

ELEVATION: 2019' K. B. TOTAL DEPTH: 3484'

PRODUCTION: D & A RIG NO: #3

CASING - 8-5/8": 205.61' of used 28# cemented with 120 sxs common 3% cc 2% gel cement circ.  
5-1/2":

ALL MEASUREMENTS TAKEN FROM THE TOP OF ROTARY BUSHING:

FROM	TO	FORMATION	DEVIATION FROM VERTICAL	REMARKS:
0'	214'			
214'	327'	sand and clay		
327'	1083'	sand and clay		
1083'	1292'	sand and shale		
1292'	1434'	shale and sand		
1434'	1468'	anhydrite		
1468'	1510'	shale		
1510'	1531'	shale		
1531'	1746'	shale	1531' - 3/4 degree	
1746'	2034'	shale and sand		
2034'	2265'	shale and lime		
2265'	2510'	shale and lime		
2510'	2700'	lime and shale		
2700'	2852'	lime and shale		
2852'	2852'	lime and shale		
2852'	2945'	lime and shale		
2945'	3063'	lime and shale		
3063'	3163'	lime and shale		
3163'	3164'	lime and shale	3164' - 1 degree	
3164'	3200'	lime and shale		
3200'	3275'	lime and shale		
3275'	3360'	lime and shale		
3360'	3389'	lime and shale		
3389'	3404'	lime and shale	3389' - 1 degree	
3404'	3457'	lime and shale		
3457'	3464'	lime and shale		
3464'	3464'	lime and shale		
3464'	3484'	lime and shale		
3484'	RTD			

STATE OF KANSAS  
COUNTY OF


The undersigned hereby certifies that to the best of his knowledge and belief, the above facts are true and correct

PIONEER DRILLING CO. INC.

By Charles Hemes

SUBSCRIBED AND SWORN TO, BEFORE ME, This 24<sup>th</sup> day of Sept., 1980.

Connie Jo Austin  
NOTARY PUBLIC

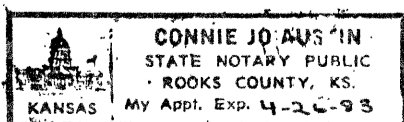

RECEIVED  
STATE CORPORATION COMMISSION

OCT 14 1980  
OCT 14 1980  
CONSERVATION DIVISION  
Wichita, Kansas