


STATE OF KANSAS
STATE CORPORATION COMMISSION

Give All Information Completely
Make Required Affidavit
Mail or Deliver Report to:
Conservation Division
State Corporation Commission
800 Bitting Building
Wichita, Kansas

15-163-01401-00-00
WELL PLUGGING RECORD

NORTH

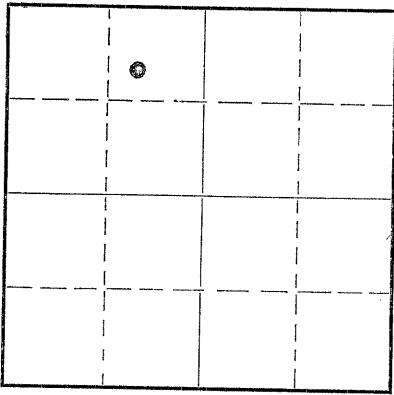

Locate well correctly on above
Section Plat

Rooks County, Sec. 22 Twp. 8 Rge. 19 ~~W~~ W..(W)
Location as "NE/CNW $\frac{1}{4}$ SW $\frac{1}{4}$ " or footage from lines SW NE NW
Lease Owner Northern Pump Company
Lease Name Peterson
Office Address Columbia Hts. P. O., Minneapolis 21, Minn. Well No. 2
Character of Well (completed as Oil, Gas or Dry Hole) Oil
Date well completed August 3 19 48
Application for plugging filed May 7 19 51
Application for plugging approved May 9 19 51
Plugging commenced May 19 19 51
Plugging completed May 28 19 51
Reason for abandonment of well or producing formation Dry

If a producing well is abandoned, date of last production March 10 19 51
Was permission obtained from the Conservation Division or its agents before plugging was commenced? Yes

Name of Conservation Agent who supervised plugging of this well Eldon Petty
Producing formation Arbuckle Depth to top 3428 Bottom 3437 Total Depth of Well 3437 Feet
Show depth and thickness of all water, oil and gas formations.

OIL, GAS OR WATER RECORDS

CASING RECORD

Formation	Content	From	To	Size	Put In	Pulled Out
Arbuckle	Oil			8-5/8" 5 1/2"	127' 3428'	None 2688'

Describe in detail the manner in which the well was plugged, indicating where the mud fluid was placed and the method or methods used in introducing it into the hole. If cement or other plugs were used, state the character of same and depth placed, from _____ feet to _____ feet for each plug set.

Pulled 2688 ft. 5 1/2 inch casing. Mudded with commercial mud from bottom of hole up to 250 ft. Pumped in with Sun Cementing Company 35 sacks cement. Mudded hole back to 30 ft. Dumped 10 sacks cement in top of 8-5/8 inch surface casing.

RECEIVED
STATE CORPORATION COMMISSION
JUN - 2 1951
CONSERVATION DIVISION
Wichita, Kansas
6/2/51

(If additional description is necessary, use BACK of this sheet)

Correspondence regarding this well should be addressed to Northern Ordnance Inc.
Address Columbia Hts. P. O., Minneapolis 21, Minn.

STATE OF Kansas, COUNTY OF Barton, ss.
Austin Brady

(employee of owner) or (owner or operator) of the above-described well, being first duly sworn on oath, says: That I have knowledge of the facts, statements, and matters herein contained and the log of the above-described well as filed and that the same are true and correct. So help me God.

(Signature)

Austin Brady

Box 317, Great Bend, Kansas
(Address)

SUBSCRIBED AND SWORN to before me this 1 day of June, 1951

My commission expires

Oct. 23, 1954

Gene Kelly

Notary Public.

22-5138-s 9-48-10M

PLUGGING
FILE SEC 22 T 8 R 19 W
BOOK PAGE 80 LINE 27

H. & H. Drilling Co.
P. O. Box 54
Wichita, Kansas

15-163-01401-00-00

Peterson #2
SW NE NW Sec. 22-88-19W
Rooks County, Kansas

EL. D.P. 1990'

TOTAL DEPTH: 3435'
Commenced: 7-8-48
Completed: 8-3-48
Casing: 8-5/8" --- 127' --- 100 Sx. Atlas Cement

Figures indicate bottom of formation:

0	to	45	Clay and Shale	
45		127	Blue Shale	
127		500	Shale	
500		820	Shale and Shells	
820		830	Anhydrite	
830		1390	Shale	
1390		1590	Shale - Shells - Salt	
1590		1830	Salt and Shale	
1830		1970	Shale	
1970		2100	Broken Lime	
2100		2220	Lime	
2220		2355	Lime and Shale	
2355		2515	Shale and Shells	
2515		2625	Shale	
2625		2690	Lime	
2690		2880	Broken Lime	
2880		3035	Lime and Shale	
3035		3120	Lime	
3120		3150	Lime	
3150		3214	Lime	
3214		3222	Lime	
3222		3245	Lime	
3245		3303	Lime	
3303		3359	Lime	
3359		3431	Lime	
3431		3432	Lime	
		3432	T. D.	
			Topeka	2950
			Heebner Shale	3138
			Brown Lime	3166
			Lansing-K.G.	3180
			Marmaton	3395
			Arbuckle	3428
			Rotary T. D.	3430

RECEIVED
STATE CORPORATION COMMISSION

MAY 9 - 1951

PLUGGING
FILE SEC 22-88-19W R 194
BOOK PAGE 80 WE 27
CONSERVATION DIVISION
Wichita, Kansas

5/9/57