

15-163-20695-08-00


STATE OF KANSAS  
STATE CORPORATION COMMISSION

WELL PLUGGING RECORD

Give All Information Completely  
Make Required Affidavit  
Mail or Deliver Report to  
Conservation Division  
State Corporation Comm.  
245 North Water  
Wichita, KS 67202

Rooks County. Sec. 22 Twp. 8 Rge. 19 ~~NE~~/W  
Location as "NE/CNW $\frac{1}{4}$ SW $\frac{1}{4}$ " or footage from lines  
250' W, SE NE NE

Lease Owner Southern States Oil Company  
Lease Name Kellogg Well No. A-1  
Office Address Box 1365, Great Bend, Kansas  
Character of Well (Completed as Oil, Gas or Dry Hole) Dry Hole

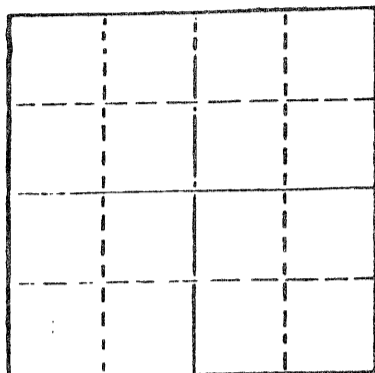

Locate well correctly on above  
Section Plat

Date Well completed May 17 1977  
Application for plugging filed May 17 1977  
Application for plugging approved May 17 1977  
Plugging commenced May 17 1977  
Plugging completed May 17 1977

Reason for abandonment of well or producing formation  
Dry Hole

If a producing well is abandoned, date of last production  
19

Was permission obtained from the Conservation Division or  
its agents before plugging was commenced? yes

Name of Conservation Agent who supervised plugging of this well Leo Massey  
Producing formation \_\_\_\_\_ Depth to top \_\_\_\_\_ Bottom \_\_\_\_\_ Total Depth of Well 3405  
Show depth and thickness of all water, oil and gas formations.

OIL, GAS OR WATER RECORDS

CASING RECORD

FORMATION	CONTENT	FROM	TO	SIZE	PUT IN	PULLED OUT

Describe in detail the manner in which the well was plugged, indicating where the mud fluid was placed and the method or methods used in introducing it into the hold. If cement or other plugs were used, state the character of same and depth placed, from \_\_\_\_\_ feet to \_\_\_\_\_ feet for each plug set.

Hole full of heavy mud to 500' w/70 sacks 50/50 Pozmix, 2% Gel, thru drill pipe  
Mud to 240' w/20 sacks 50/50 Pozmix, 2% Gel, thru drill pipe  
Mud to 40' w/ $\frac{1}{2}$  sack hulls plug and 10 sacks cement  
2 sacks cement in rat hole

RECEIVED  
STATE CORPORATION COMMISSION  
MAY 20 1977 5/20/77

(If additional description is necessary, use BACK of this sheet)  
Name of Plugging Contractor Duke Drilling Wichita, Kansas

STATE OF KANSAS COUNTY OF BARTON, ss.  
Larry Curtis (employee of owner) or (owner/operator)

of the above-described well, being first duly sworn on oath, says: That I have knowledge of the facts, statements, and matters herein contained and the log of the above-described well as filed and that the same are true and correct. So help me God.

(Signature) Larry Curtis  
Box 823, Great Bend, Kansas 67530  
(Address)

SUBSCRIBED AND SWORN TO before me this 18th day of May, 19 77

My commission expires 4-11-78  
Walter M. Hague  
Notary Public.

DRILLERS' WELL LOG

15-163-20695-00-00

DATE COMMENCED: May 11, 1977  
DATE COMPLETED: May 17, 1977

Southern States Oil Company  
KELLOGG A-1  
250' W, SE NE NE  
Sec 22-T8-R19W  
Rooks County, Kansas

ELEVATION: 1947 K.B.

0 - 1076' Sand and Shale  
1076 - 1348' Red Bed  
1348 - 1390' Anhydrite  
1390 - 1850' Shale  
1850 - 2245' Shale and Lime  
2245 - 3037' Lime and Shale  
3037 - 3101' Lime  
3101 - 3105' Shale  
3105 - 3123' Lime and Shale  
3123 - 3405' Lime  
3405' RTD

FORMATION TOPS

Anhydrite 1348  
Heebner 3101  
Toronto 3123  
Lansing 3140  
RTD 3405

SURFACE PIPE: Set used  
8 5/8", 28# pipe at 257'  
w/160 sacks Common, 2% Gel,  
3% cc.

A F F I D A V I T

STATE OF KANSAS }  
COUNTY OF BARTON } ss.

Larry Curtis, of lawful age, does swear and state that the facts and statements herein contained are true and correct to the best of his knowledge.

Larry Curtis

Subscribed and sworn to before me this 19th day of May, 1977.

Joanne C. Estes  
Notary Public

My Commission Expires: 7-17-79

8/20/77  
MAY 20 1977  
CONSERVATION DIVISION  
Picher, Kansas