

15-163-00470-0000


STATE OF KANSAS
STATE CORPORATION COMMISSION

Give All Information Completely
Make Required Affidavit
Mail or Deliver Report to:
Conservation Division
State Corporation Commission
800 Bitting Building
Wichita, Kansas

WELL PLUGGING RECORD

Rooks County, Sec. 23 Twp. 8 (E) 19 (W)

Location as "NE/CNW $\frac{1}{4}$ SW $\frac{1}{4}$ " or footage from lines NW NW SE
Lease Owner Keating Drg Co
Lease Name Drake Green Well No. 1
Office Address Natl Bank of Tuls Bldg Tulsa, Okla
Character of Well (completed as Oil, Gas or Dry Hole) Dry
Date well completed 6-20-52 19
Application for plugging filed 6-20-52 19
Application for plugging approved 6-20-52 19
Plugging commenced 6-20-52 19
Plugging completed 6-20-52 19
Reason for abandonment of well or producing formation Dry

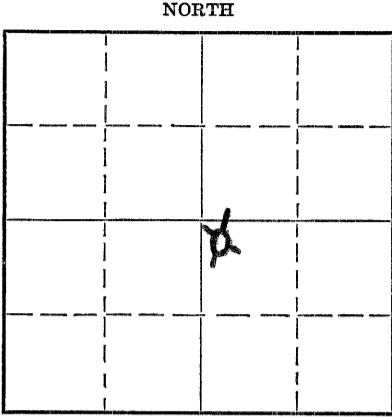

Locate well correctly on above
Section Plat

If a producing well is abandoned, date of last production 19
Was permission obtained from the Conservation Division or its agents before plugging was commenced? Yes

Name of Conservation Agent who supervised plugging of this well Eldon R. Petty
Producing formation none Depth to top Bottom Total Depth of Well 5460 Feet
Show depth and thickness of all water, oil and gas formations.


OIL, GAS OR WATER RECORDS

CASING RECORD

Formation	Content	From	To	Size	Put In	Pulled Out
				8 1/2" 8"	187'	none

Describe in detail the manner in which the well was plugged, indicating where the mud fluid was placed and the method or methods used in introducing it into the hole. If cement or other plugs were used, state the character of same and depth placed, from feet to feet for each plug set.

circulated hole with heavy mud, pushed cementing plug to 180', displaced 15 sax cement through drill pipe, mud to 40', set cementing plug, 1/2 sack hulls and 10 sax cement filling hole to bottom cellar.

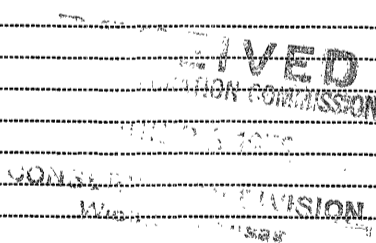

(If additional description is necessary, use BACK of this sheet)

Correspondence regarding this well should be addressed to Keating Drg Co 6-26-52
Address Natl Bank of Tulsa Bldg Tulsa, Okla

STATE OF Kansas COUNTY OF Rooks, ss.
Hugh Britain (employee of owner) or (owner or operator) of the above-described well,
being first duly sworn on oath, says: That I have knowledge of the facts, statements, and matters herein contained and the log of the above-described well as filed and that the same are true and correct. So help me God.

(Signature) Hugh Britain
25 West 4th Street
(Address)

SUBSCRIBED AND SWORN TO before me this 25 day of June 1952

My commission expires 11-14-53
E Charles Hagaman Notary Public.

23 8 1952
26

15-163-00470-00-00

COMPANY A.F. Keating, 510 Natl. Bank of Tulsa Bldg., Tulsa 3, Okla.
Farm Y Dradie Green Well No. 1 Loc: NW NW SE Sec 23-8-19W
Total Depth: 3460' County: Rooks, Kansas.
Comm: 6-8-52 Comp: 6-20-52 Prod. D & A
Tools: Keating Drilling Co. Elev. 1964 RB
Casing: 187' 8 5/8 set at 193'RB Time Log: Geolograph
Elec. Log Schlumberger

0- 60 shale
60- 70 gravel
70- 195 shale
195- 220 shells
220- 460 sand & shale
460- 998 sand, shale & shells
998- 1080 shale & shells
1080-1370 red bed
1370-1420 anhydrite
1420-1738 red bed & shale
1738-1755 salt
1755-1808 shale
1808-2131 anhydrite & shale
2131-2787 sdy. shale, sand & lime
2787-2843 shale & lime
2843-2953 sdy. shale & lime
2953-2985 lime
2985-3000 shaley lime
3000-3068 lime & shale
3068-3073 sand
3073-3082 lime & sand
3082-3143 lime & shale
3143-3180 lime (hard)
3180-3217 lime
3217-3257 lime & shale
3257-3335 lime
3335-3410 lime & shale
3410-3430 sdy. sh. & dolo.
3430-3460 dolo. & lime
T.D. 3460

TOPS

Anhydrite 1369
Topeka 2908
Heebner 3115
Toronto 3136
Lansing 3153
Base K/C 3373
Cong. 3404
Arbuckle 3424
T.D. 3460

NO SHOWS

Stain 3196-3201 spotted, poor por.
Stain 3238-3240 trace, spot, very poor por.
Stain 3320-28 dk; spotted, poor por.

State of Kansas County of Sedgwick S.S.

Dale Martin, representative of operator of above described well, being first duly sworn on oath, states - That I have knowledge of the facts, statements and matters herein contained, and the log of the above well as filed, and that the same are true and correct. So help me God.

Signature Dale Martin
836 Marcilene, Wichita 17, Kans.

Subscribed and sworn to before me this 26 day of June, 1952.



My Commission Expires:
October 17, 1953

Dorothy M. Barber
Notary Public
JUN 30 1952 630-52

CONSERVATION DIVISION
Wichita, Kansas

PLUGGING
FILE SEC 23 T 8 R 19W
BOOK PAGE 26 LINE 27