

WELL PLUGGING RECORD

Give All Information Completely
Make Required Affidavit
Mail or Deliver Report to
Conservation Division
State Corporation Comm.
200 Colorado Derby Bldg.
202 W. 1st St.
Wichita, KS 67202

Rooks County Sec. 23 Twp. 8s Rge. 19 W
Location as "NE/CNW/SW" or footage from lines

SE NW NE

Lease Owner Liberty Enterprises, Inc.

Lease Name Kellogg Well No. #1

Office Address 308 West Mill Plainville, Ks 67663

Character of Well (Completed as Oil, Gas or Dry Hole) Dry Hole

Date Well completed September 22 19 81

Application for plugging filed September 22 19 81

Application for plugging approved September 22 19 81

Plugging commenced 10:30 A.M. September 22 19 81

Plugging completed 11:45 A.M. September 22 19 81

Reason for abandonment of well or producing formation
No Commercial Production


If a producing well is abandoned, date of last production
19

Was permission obtained from the Conservation Division or
its agents before plugging was commenced? Yes

Name of Conservation Agent who supervised plugging of this well Marion Schmidt

Producing formation Depth to top Bottom Tl. Depth of Well

Show depth and thickness of all water, oil and gas formations.

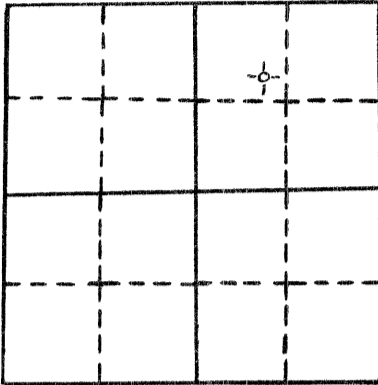

locate well correctly
on above
Section Plot

OIL, GAS OR WATER RECORDS

CASING RECORD

FORMATION	CONTENT	FROM	TO	SIZE	PUT IN	PULLED OUT
Surface Casing	common	0'	198.11'	8 5/8"	198.11'	0'

Describe in detail the manner in which the well was plugged, indicating where the mud fluid was placed and the method or methods used in introducing it into the hold. If cement or other plugs were used, state the character of same and depth placed, from feet to feet for each plug set.

Plug #1 800' with 70sxs

Plug #2 200' with 40sxs

Plug #3 40' with 10sxs

5sxs in rathole

Total 125sxs 50-50pos 6%gel P.D.@ 11:45 A.M.

(If additional description is necessary, use BACK of this sheet)


Name of Plugging Contractor Pioneer Drilling Co.

308 West Mill Plainville, Ks 67663

STATE OF Kansas COUNTY OF Rooks, ss.

David L. Comeau

(employee of owner) or (owner or operator) of the above described well, being first duly sworn on oath, says: That I have knowledge of the facts, statements, and matters herein contained and the log of the above described well is filed and that the same are true and correct. So help me God.

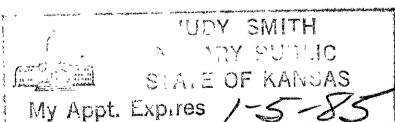

(Signature) David L. Comeau

(Address) 308 W MILL ST
Plainville, Ks.

SUBSCRIBED AND SWORN TO before me this 28th day of September, 19 81

My commission expires

Judy Smith
Notary Public

15-163-20993-00-00

RECEIVED
STATE CORPORATION COMMISSION

SEP 30 1981
9-30-81
CONSERVATION DIVISION
Wichita, Kansas

WELL LOG

OPERATOR: Liberty Enterprises, Inc.

WELL NAME: Kellogg #1 LOCATION: SE NW NE 23-8s-19W

COUNTY: Rooks STATE: Kansas

WELL COMMENCED: September 15, 1981 WELL COMPLETED: September 22, 1981

ELEVATION: 2010' K.B. TOTAL DEPTH: 3515'

PRODUCTION: D & A RIG NO: #2

CASING - 8 5/8": 5 Jts new 22# ^{set @ 198.11'} cemented with 125 sxs common 2%gel 3%cc P.D.@ 3:45 A.M.9-16-81

5 1/2": _____

ALL MEASUREMENTS TAKEN FROM THE TOP OF ROTARY BUSHING:

FROM	TO	FORMATION	DEVIATION FROM VERTICAL	REMARKS:
0'	208'	sand and shale	208' - 0 degree	
208'	1350'	sand and shale		
1350'	1410'	sand and shale		
1410'	1448'	anhydrite		
1448'	1690'	sand and shale		
1690'	2020'	shale and shells	1900' - 1 1/4 degree	
2020'	2208'	lime and shale		
2208'	2300'	lime and shale	2300' -3/4 degree	
2300'	2553'	lime and shale		
2553'	2743'	lime and shale		
2743'	2850'	lime and shale		
2850'	3012'	lime and shale		
3012'	3110'	lime and shale		
3110'	3185'	lime and shale		
3185'	3266'	lime and shale		
3266'	3328'	shale and lime		
3328'	3385'	lime and shale		
3385'	3447'	lime and shale		
3447'	3515'	arbuckle		
3515'	R.T.D.			

STATE OF KANSAS
COUNTY OF _____

The undersigned hereby certifies that to the best of his knowledge and belief, the above facts are true and correct

PIONEER DRILLING CO., INC.

By Harry A. Hilgers

SUBSCRIBED AND SWORN TO, BEFORE ME, This 28th day of September, 1981

Judy Smith
NOTARY PUBLIC

