

STATE CORPORATION COMMISSION OF KANSAS
OIL & GAS CONSERVATION DIVISION

WELL COMPLETION OR RECOMPLETION FORM
ACO-1 WELL HISTORY

DESCRIPTION OF WELL AND LEASE

Operator: license # 6113
name Landmark Oil Exploration, Inc.
address 105 S. Broadway, Suite 1040
City/State/Zip Wichita, Kansas 67202

Operator Contact Person Mel Hussey
Phone (316) 265-8181

Contractor: license # 5420
name White & Ellis Drilling, Inc.

Wellsite Geologist Steve Carl
Phone (316) 265-8181

PURCHASER N/A

Designate Type of Completion
 New Well Re-Entry Workover

Oil SWD Temp Abd
 Gas Inj Delayed Comp.
 Dry Other (Core, Water Supply etc.)
KCC

If OWWO: old well info as follows:
Operator
Well Name
Comp. Date Old Total Depth

WELL HISTORY

Drilling Method: Mud Rotary Air Rotary Cable
7-18-84 7-23-84 7-23-84
Spud Date Date Reached TD Completion Date

3490'
Total Depth PBD

Amount of Surface Pipe Set and Cemented at 286' @ 293' feet

Multiple Stage Cementing Collar Used? Yes No

If Yes, Show Depth Set feet

If alternate 2 completion, cement circulated
from feet depth to w/ SX cmt

API NO. 15-163-22,417 -00-00

County Rooks

SE NW SE Sec 30 Twp 8-S Rge 19 East West

1650 Ft North from Southeast Corner of Section
1650 Ft West from Southeast Corner of Section
(Note: locate well in section plat below)


Lease Name Wolfenden Well# 1-30

Field Name

Producing Formation

Elevation: Ground 1999' KB 2003'

Section Plat

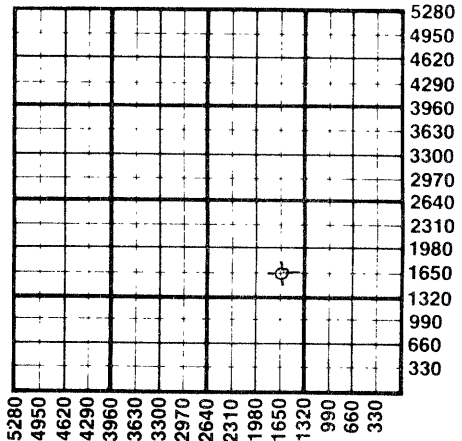

WATER SUPPLY INFORMATION

Source of Water:
Division of Water Resources Permit #

Groundwater Ft North From Southeast Corner and
(Well) Ft West From Southeast Corner of
Sec Twp Rge East West

Surface Water Ft North From Southeast Corner and
(Stream, Pond etc.) Ft West From Southeast Corner
Sec Twp Rge East West

Other (explain) purchased from Russell Bouchey in
Stockton, Kansas
(purchased from city, R.W.D.#)

Disposition of Produced Water: Disposal Repressuring

Docket #

INSTRUCTIONS: This form shall be completed in duplicate and filed with the Kansas Corporation Commission, 200 Colorado Derby Building, Wichita, Kansas 67202, within 90 days after completion or recompletion of any well. Rules 82-3-130 and 82-3-107 apply.

Information on side two of this form will be held confidential for a period of 12 months if requested in writing and submitted with the form. See rule 82-3-107 for confidentiality in excess of 12 months.

One copy of all wireline logs and drillers time log shall be attached with this form. Submit CP-4 form with all plugged wells. Submit CP-111 form with all temporarily abandoned wells.

All requirements of the statutes, rules, and regulations promulgated to regulate the oil and gas industry have been fully complied with and the statements herein are complete and correct to the best of my knowledge.

Signature Merlin C. Hussey
Title Exploration Manager

RECEIVED
STATE CORPORATION COMMISSION
AUG 23 1984
08-23-1984
CONSERVATION DIVISION
Wichita, Kansas

Date 7-26-84

Subscribed and sworn to before me this 26th day of July 1984

Notary Public Marilyn Evenson
Date Commission Expires

MARILYNN EVENSON
NOTARY PUBLIC
STATE OF KANSAS
MY APPT. EXPIRES 7-6-87

K.C.C. OFFICE USE ONLY
F Letter of Confidentiality Attached
C Wireline Log Received
C Drillers Timelog Received
Distribution
 KCC SWD/Rep NGPA
 KGS Plug Other
(Specify)

Sec. 30 Twp. 8 Rge. 19

SIDE TWO

Operator Name Landmark Oil Exploration Lease Name Wolfenden Well# 1-30 SEC 30 TWP. 8-S RGE. 19 East West

WELL LOG

INSTRUCTIONS: Show important tops and base of formations penetrated. Detail all cores. Report all drill stem tests giving interval tested, time tool open and closed, flowing and shut-in pressures, whether shut-in pressure reached static level, hydrostatic pressures, bottom hole temperature, fluid recovery, and flow rates if gas to surface during test. Attach extra sheet if more space is needed. Attach copy of log.

Drill Stem Tests Taken Yes No
 Samples Sent to Geological Survey Yes No
 Cores Taken Yes No

Formation Description
 Log Sample

Name	Top	Bottom
Anhydrite	1464'	(+539)
Heebner	3177'	(-1174)
Toronto	3200'	(-1197)
Lansing	3219'	(-1216)
Lansing "D"	3274'	(-1217)
Muncie Creek	3337'	(-1334)
Lansing "J"	3386'	(-1383)
Stark	3399'	(-1396)
BKC	3434'	(-1431)
Arbuckle	3463'	(-1460)

CASING RECORD <input checked="" type="checkbox"/> new <input type="checkbox"/> used Report all strings set - conductor, surface, intermediate, production, etc.							
Purpose of string	size hole drilled	size casing set (in O.D.)	weight lbs/ft.	setting depth	type of cement	# sacks used	type and percent additives
Surface	12 1/4"	8 5/8"	24#	293'	Common	175	2% gel, .3# CC.
PERFORATION RECORD				Acid, Fracture, Shot, Cement Squeeze Record			
shots per foot	specify footage of each interval perforated			(amount and kind of material used)			Depth
TUBING RECORD				Liner Run <input type="checkbox"/> Yes <input type="checkbox"/> No			
Date of First Production	Producing method <input type="checkbox"/> flowing <input type="checkbox"/> pumping <input type="checkbox"/> gas lift <input type="checkbox"/> Other (explain)						
Estimated Production Per 24 Hours	Oil	Gas	Water	Gas-Oil Ratio	Gravity		
	Bbls	MCF	Bbls	CFPB			

Disposition of gas: vented sold used on lease

METHOD OF COMPLETION open hole perforation other (specify)

PRODUCTION INTERVAL

Dually Completed. Commingled