


15-163-00894-00-00

Give All Information Completely
Make Required Affidavit
Mail or Deliver Report to:
Conservation Division
State Corporation Commission
211 No. Broadway
Wichita, Kansas

WELL PLUGGING RECORD

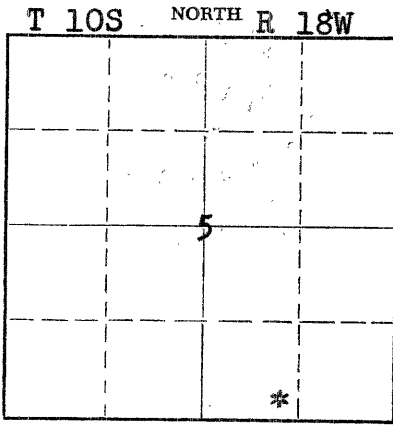

Locate well correctly on above Section Plat

Ellis County. Sec. 5 Twp. 10S Rge. 18W (E) (W)
Location as "NE/CNW/SW" or footage from lines SE SW SE
Lease Owner K. & E. Drilling, Inc.
Lease Name Williams Well No. 1
Office Address 1006 Central Bldg. - Wichita, Kansas
Character of Well (completed as Oil, Gas or Dry Hole) _____
Date well completed _____ 19____
Application for plugging filed _____ 19____
Application for plugging approved _____ 19____
Plugging commenced November 28 19 56
Plugging completed December 1 19 56
Reason for abandonment of well or producing formation _____

If a producing well is abandoned, date of last production _____ 19____
Was permission obtained from the Conservation Division or its agents before plugging was commenced? Yes

Name of Conservation Agent who supervised plugging of this well Eldon Petty
Producing formation _____ Depth to top _____ Bottom _____ Total Depth of Well 3466 Feet
Show depth and thickness of all water, oil and gas formations.

OIL, GAS OR WATER RECORDS

CASING RECORD

FORMATION	CONTENT	FROM	TO	SIZE	PUT IN	PULLED OUT
				8-5/8"	204'	None
				4-1/2"	3462'	2776'
				Hole was plugged back to 3435' and casing perforated from 3394' to 3399'.		

Describe in detail the manner in which the well was plugged, indicating where the mud fluid was placed and the method or methods used in introducing it into the hole. If cement or other plugs were used, state the character of same and depth placed, from _____ feet to _____ feet for each plug set.

Filled the hole with sand from 3435' to 3376' and ran 3 sacks of cement which filled to 3361'. Mudded the hole from 3361' to 210', set a 10' rock bridge and ran 15 sacks of cement. Mudded the hole to 30', set a rock bridge and ran 10 sacks of cement to base of cellar. Plugging completed.

(If additional description is necessary, use BACK of this sheet)
Name of Plugging Contractor West Supply Co., Inc.
Address Chase, Kansas

STATE OF KANSAS, COUNTY OF SEDGWICK, ss.
Dale Silcott (employee of owner) or (owner or operator) of the above-described well, being first duly sworn on oath, says: That I have knowledge of the facts, statements, and matters herein contained and the log of the above-described well as filed and that the same are true and correct. So help me God.

(Signature) Dale Silcott
DALE SILCOTT, K & E DRILLING, INC.
719 Union Center Building, Wichita, Kansas
(Address)

SUBSCRIBED AND SWORN to before me this 11 day of December, 19 56

My commission expires 11 August 1958.

Patricia M. Edwards
Notary Public.

PLUGGING
SEC. 5 T. 10 R. 18W
BOOK PAGE 108 LINE 1

12-12-1956
DIVISION

K & E DRILLING, INC.
Williams #1

SE SW SE Sec 5-108-18W
Rooks County, Kansas

Comm: 1-8-55
Comp: 1-19-55
Total Depth: 3790'

15-163-00894-00-00

Casing

8 5/8" Set @ 204'
4 1/2" Set @ 3462'

Cement

125 sacks
75 sacks

FORMATION

DEPTH

Surface Sand & soil	0 - 90
Shale & sand	90 - 170
Shale	170 - 199
Shale & shells	199 - 700
Shale & sand	700 - 910
Shale	910 - 1125
Sand	1125 - 1280
Red bed	1280 - 1537
Anhydrite	1537 - 1600
Shale & shells	1600 - 1870
Shale & lime	1870 - 3060
Shale	3060 - 3160
Lime	3160 - 3190
Lime & shale	3190 - 3401
Lime	3401 - 3620
Lime & shale	3620 - 3640
Conglomerate	3640 - 3725
Simpson Sand	3725 - 3742
Shale lime	3742 - 3777
Artuckle	3777 - 3790

State of Kansas)
) SS
Sedgwick County)

I hereby certify that the above information is true and correct to the best of my knowledge.

Subscribed and sworn to before me this 24th day of January, 1955.

Francis M. Miller
Notary Public

My Commission expires: June 25, 1956

RECEIVED
DIVISION
12-12-1954
KANSAS

PLUGGING
FILE SEC 5 T 10 R 18W
BOOK PAGE 108 LINE 1