


STATE OF KANSAS
STATE CORPORATION COMMISSION

WELL PLUGGING RECORD

Information Completely
Required Affidavit
Deliver Report to:
Conservation Division
State Corporation Commission
211 No. Broadway
Wichita, Kansas

NORTH

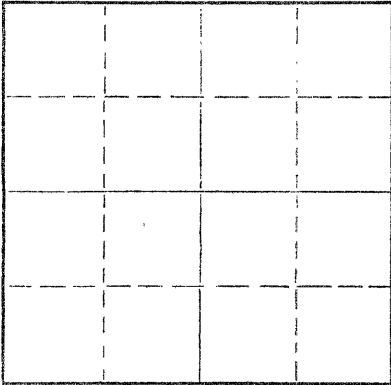

Locate well correctly on above
Section Plat

Rooks County. Sec. 15 Twp. 10 Rge. 18 (E) W (W)
Location as "NE/CNW/SW" or footage from lines NW-NE
Lease Owner Allen T Fender
Lease Name Helgers Well No. 4-1
Office Address Russell, Kansas
Character of Well (completed as Oil, Gas or Dry Hole) _____
Date well completed _____ 19____
Application for plugging filed _____ 19____
Application for plugging approved _____ 19____
Plugging commenced Dec. 31 19 62
Plugging completed Jan. 24 19 63
Reason for abandonment of well or producing formation _____

If a producing well is abandoned, date of last production _____ 19____
Was permission obtained from the Conservation Division or its agents before plugging was commenced? Yes
Petty

Name of Conservation Agent who supervised plugging of this well _____
Producing formation _____ Depth to top _____ Bottom _____ Total Depth of Well 3740 Feet
Show depth and thickness of all water, oil and gas formations.

OIL, GAS OR WATER RECORDS

CASING RECORD

FORMATION	CONTENT	FROM	TO	SIZE	PUT IN	PULLED OUT

Describe in detail the manner in which the well was plugged, indicating where the mud fluid was placed and the method or methods used in introducing it into the hole. If cement or other plugs were used, state the character of same and depth placed, from 3740 feet to surface feet for each plug set.
Sanded up to 3430' Pipe pre. at 3441' pulled pipe up to 570' circ. with mud pump 20 sacks of cement to 570', Pulled pipe up to 180' pump 20 sacks of cement to 180' pulled pipe from hole put 10 sacks of cement on top, Well completed.

RECEIVED
STATE CORPORATION COMMISSION

AUG 6 1963

08-06-1963
CONSERVATION DIVISION
Wichita, Kansas

RECEIVED
STATE CORPORATION COMMISSION

FEB 14 1963

CONSERVATION DIVISION
Wichita, Kansas

(If additional description is necessary, use BACK of this sheet)
Name of Plugging Contractor Barnes & Sons Pipe Pulling Co.
Address Russell, Kansas

STATE OF Kansas, COUNTY OF Russell, ss.
Allen T Fender (employee of owner) or (owner or operator) of the above-described well, being first duly sworn on oath, says: That I have knowledge of the facts, statements, and matters herein contained and the log of the above-described well as filed and that the same are true and correct. So help me God.

(Signature) Allen T Fender
Russell, Kansas
(Address)

SUBSCRIBED AND SWORN TO before me this 1st day of February, 1963

My commission expires May 26, 1963

Ruth Phillips
Notary Public.

