


15-163-00495-00-00

WELL PLUGGING RECORD

Give All Information Completely
Make Required Affidavit
Mail or Deliver Report to:
Conservation Division
State Corporation Commission
800 Bitting Building
Wichita, Kansas

Rooks County. Sec. 5 Twp. 10 Rge. (E) 18 (W)
Location as "NE/CNW $\frac{1}{4}$ SW $\frac{1}{4}$ " or footage from lines SW SW NE
Lease Owner Graham-Messman-Rinehart Oil Company
Lease Name Hilgers "A" Well No. 1
Office Address 1005 E. Second St., Wichita, Kansas
Character of Well (completed as Oil, Gas or Dry Hole) Dry Hole
Date well completed March 29, 1953 19 53
Application for plugging filed March 29, 19 53
Application for plugging approved April 1, 19 53
Plugging commenced March 30, 19 53
Plugging completed March 30, 19 53
Reason for abandonment of well or producing formation Dry Hole

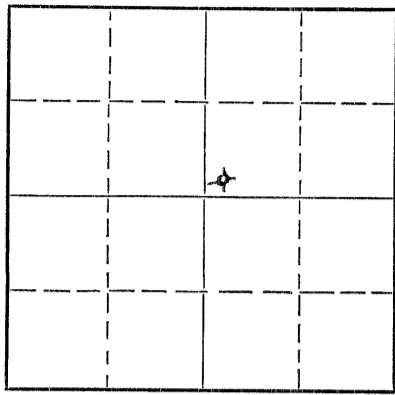

Locate well correctly on above
Section Plat

If a producing well is abandoned, date of last production 19
Was permission obtained from the Conservation Division or its agents before plugging was commenced? yes

Name of Conservation Agent who supervised plugging of this well Mr. Eldon Petty, Box 326, Hays, Kansas
Producing formation Depth to top Bottom Total Depth of Well 3801 Feet
Show depth and thickness of all water, oil and gas formations.

OIL, GAS OR WATER RECORDS

CASING RECORD

Formation	Content	From	To	Size	Put In	Pulled Out
				8 5/8"	180'	none

Describe in detail the manner in which the well was plugged, indicating where the mud fluid was placed and the method or methods used in introducing it into the hole. If cement or other plugs were used, state the character of same and depth placed, from feet to feet for each plug set.

Mud to 170'. Bottom plug @ 170'
w/ $\frac{1}{2}$ sk. hulls and 15 sx. cement.
Top plug @ 40' w/ $\frac{1}{2}$ sk. hulls and
10 sx. cement. Mud to surface.

04-14-1953

(If additional description is necessary, use BACK of this sheet)

Name of Plugging Contractor Graham-Messman-Rinehart Oil Company
Address 1005 E. Second St., Wichita, Kansas

STATE OF Kansas, COUNTY OF Sedgwick, ss.
J. A. Gilliland (employee of owner or owner or operator) of the above-described well,
being first duly sworn on oath, says: That I have knowledge of the facts, statements, and matters herein contained and the log of the above-described well as filed and that the same are true and correct. So help me, God.

(Signature) [Signature]
1005 E. Second St., Wichita, Kansas (Address)

SUBSCRIBED AND SWORN to before me this 3rd day of April, 19 53

My commission expires December 1, 1956

PLUGGING
FILE SEC 5 T 10 R 18 W
BOOK PAGE 89 LINE 1

15-163-00495-00-00

HILGERS "A" #1

WELL RECORD

Location: SW SW NE 5-10-18W Rooks County, Kansas	Commenced: March 20, 1953
Operator: G-M-R Oil Company	Completed: March 30, 1953
Contractor: G-M-R Drilling Company	Elevation: 2188 K.B.
Casing Record: 8 5/8" @ 180' w/100 sx. cement	Production: D & A

LOG

Sod	30
Sand	70
Shale	85
Sand	95
Shale #1	180
Shale Shells	920
Iron Shale	1075
Sand	1305
Shale Red Bed	1415
Shale	1581
Anhydrite	1617
Shale	1632
Shale	1770
Shale Lime	2125
Lime & Shale	2285
Shale & Lime	2440
Lime Shale	2625
Lime & Shale	2744
Lime - Shale	2844
Shale Lime	2980
Lime & Shale	3067
Lime Shale	3190
Brown Lime	3285
Lime	3338
Lime	3395
Lime	3437
Lime	3475
K. C. Lime	3495
Lime	3545
Lime	3582
Lime	3630
Lime	3654
Conglomerate	3675
Conglomerate	3698
Lime Shale	3744
Conglomerate	3751
Arbuckle	3801 T.D.

TOPS

3154 - Topeka (-966)
3367 - Heebner (-1179)
3387 - Toronto (-1199)
3408 - Lansing (-1220)
3751 - Arbuckle (-1563)
3737 - Simpson (-1549)

The undersigned, GRAHAM-MESSMAN-RINEHART OIL COMPANY, hereby certifies that the above log is a true and correct log of the formation encountered in drilling the above well as reflected by the Daily Drilling Reports.

GRAHAM-MESSMAN-RINEHART OIL COMPANY

By: J. A. Gilliland
J. A. Gilliland

Subscribed and sworn to before me this 4th day of April, 1953.

Barbara J. Scott
Notary Public

My commission expires: December 1, 1956

APR 14 1953
CONF. 04-14-1953

PLUGGING
FILE SEC 5 T 10 R 18W
BOOK PAGE 82 LINE 1