

15-163-00105-00-00

WELL PLUGGING RECORD


STATE OF KANSAS
STATE CORPORATION COMMISSION

Give All Information Completely
Make Required Affidavit
Mail or Deliver Report to:
Conservation Division
State Corporation Commission
800 Bitting Building
Wichita, Kansas

OR
FORMATION PLUGGING RECORD

Strike out upper line
when reporting plugging
off formations.

Rooks County. Sec. 6 Twp. 10S Rge. 18 (X) W (W)
Location as "NE 1/4 NW 1/4 SW 1/4" or footage from lines. NE NE NE
Lease Owner The Vickers Petroleum Co., Inc.
Lease Name Hilgers Well No. 1
Office Address 201 W-K-H Building, Wichita, Kansas
Character of Well (completed as Oil, Gas or Dry Hole) Dry
Date well completed December 9 1948
Application for plugging filed December 9 1948
Application for plugging approved December 9 1948
Plugging commenced December 9 1948
Plugging completed December 9 1948
Reason for abandonment of well or producing formation Dry

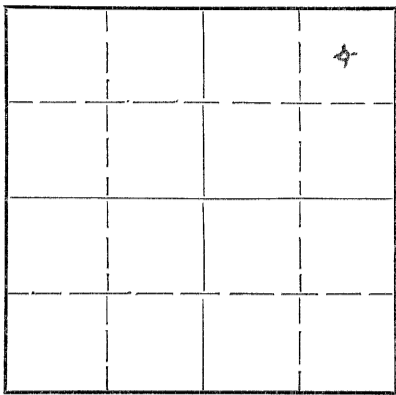

Locate well correctly on above
Section Plat

If a producing well is abandoned, date of last production 19
Was permission obtained from the Conservation Division or its agents before plugging was commenced? yes

Name of Conservation Agent who supervised plugging of this well C. D. Stough, Great Bend, Kansas
Producing formation Arbuckle Lime Depth to top 3738 Bottom 3747 Total Depth of Well 3747 Feet
Show depth and thickness of all water, oil and gas formations.

OIL, GAS OR WATER RECORDS

CASING RECORD

Formation	Content	From	To	Size	Put In	Pulled Out
Surface				8-5/8"	217	None

Describe in detail the manner in which the well was plugged, indicating where the mud fluid was placed and the method or methods used in introducing it into the hole. If cement or other plugs were used, state the character of same and depth placed, from feet to feet for each plug set.

Set plug @ 200', cemented w/15 sx. Filled w/mud to 30'. Set plug @ 30'
Cemented to base of cellar w/10 sx.

RECEIVED
DEC 14 1948
12-14-1948
NORTH
KANSAS

(If additional description is necessary, use BACK of this sheet)


Correspondence regarding this well should be addressed to The Vickers Petroleum Co., Inc.
Address 201 W-K-H Bldg., Wichita, Kansas

STATE OF Kansas, COUNTY OF Sedgwick, ss.
John M. Little (employee of owner) or (owner or operator) of the above-described well,
being first duly sworn on oath, says: That I have knowledge of the facts, statements, and matters herein contained and the log of the above-described well as filed and that the same are true and correct. So help me God.

(Signature) John M. Little
201 W-K-H Bldg., Wichita, Kansas
(Address)

SUBSCRIBED AND SWORN TO before me this 13th day of December, 1948
Allen P. Denton
Notary Public.

My commission expires August 13, 1949

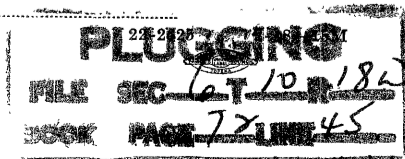

15-163-00105-00-00

THE VICKERS PETROLEUM CO., INC.

Hilger Well #1
NE 1/4 NE 1/4 NE 1/4 Sec. 6-10S-18W
Rooks County, Kansas

Casing Record:
8-5/8" @ 217' w/150 sx

Commenced: November 27, 1948
Completed: December 9, 1948

Elevation: 2191 R.B.
D & A

LOG

Shells & Gravel	0-70
Shale & Shells	70-217
Shale & Shells	217-840
Sand Shale & Shells	840-890
Sand	890-1270
Sand & Shale	1270-1535
Sand Shale & Shells	1535-1600
Anhydrite	1600-1630
Lime Broken	1630-1700
Shale & Shells	1700-2235
Lime Broken	2235-2375
Lime & Shale	2375-2465
Lime	2465-2540
Lime & shale	2540-3105
Lime	3105-3366
Lime & Shale	3366-3387
Lime	3387-3400
Shale	3400-3409
Lime	3409-3627
Shale	3627-3639
Conglomerate	3639-3738
Dolomite	3738-3747 T.D. D & A

Tops:	
Heebner	3366 R.B.
Dodge	3387 R.B.
Lansing	3409 R.B.
Base Kan. City	3627 R.B.
Conglomerate	3639 R.B.
Arbuckle	3738 R.B.

RECEIVED
12-14-1948
REGISTRATION
DIVISION

I hereby certify that this log is true and correct to the best of my knowledge and belief.

THE VICKERS PETROLEUM CO., INC.

By A. C. Davis

Subscribed and sworn to before me
this 13 day of December, 1948.

Allen J. Denton
Notary Public

My commission expires August 13, 1949.

PLUGGING
FILE SEC 6-10-18W
BOOK PAGE 78-45