


STATE OF KANSAS
STATE CORPORATION COMMISSION

Give All Information Completely
Make Required Affidavit
Mail or Deliver Report to:
Conservation Division
State Corporation Commission
800 Biting Building
Wichita, Kansas

15-163-00834-00-00
WELL PLUGGING RECORD

NORTH

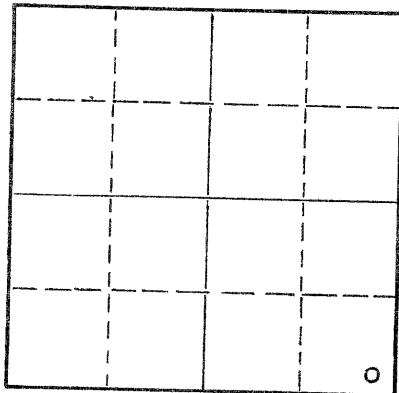

Locate well correctly on above
Section Plat

Rooks County. Sec. 7 Twp. 10 Rge. 18 (X)W (W)
Location as "NE/CNW/SW" or footage from lines SE Corner
Lease Owner ~~Wise~~ Nadel and Gussman
Lease Name Wise Well No. 1
Office Address 1714 First National Bldg. Tulsa 3, Oklahoma
Character of Well (completed as Oil, Gas or Dry Hole) Dry
Date well completed 10-19-55
Application for plugging filed 10-19-55
Application for plugging approved 10-19-55
Plugging commenced 10-19-55
Plugging completed 10-19-55
Reason for abandonment of well or producing formation Dry

If a producing well is abandoned, date of last production 19
Was permission obtained from the Conservation Division or its agents before plugging was commenced? Yes

Name of Conservation Agent who supervised plugging of this well Eldon Petty
Producing formation _____ Depth to top _____ Bottom _____ Total Depth of Well 3790 Feet
Show depth and thickness of all water, oil and gas formations.

OIL, GAS OR WATER RECORDS

					CASING RECORD	
FORMATION	CONTENT	FROM	TO	SIZE	PUT IN	PULLED OUT
				8-5/8"	168	0

Describe in detail the manner in which the well was plugged, indicating where the mud fluid was placed and the method or methods used in introducing it into the hole. If cement or other plugs were used, state the character of same and depth placed, from _____ feet to _____ feet for each plug set.

Filled hole with heavy mud from T.D. to 160' - set plug at 160'
with 15 sacks cement - set top plug at 40' with 10 sacks cement

RECEIVED
STATE CORPORATION COMMISSION
OCT 29 1955
10-29-1955
CONSERVATION DIVISION
Wichita, Kansas

(If additional description is necessary, use BACK of this sheet)
Name of Plugging Contractor Reserve Drilling Company, Inc.
Address 703 Union National Building, Wichita 2, Kansas

STATE OF KANSAS, COUNTY OF SEDGWICK, ss.
L. C. Hay (employee of owner) ~~owner or operator~~ of the above-described well, being first duly sworn on oath, says: That I have knowledge of the facts, statements, and matters herein contained and the log of the above-described well as filed and that the same are true and correct. So help me God.

(Signature) L. C. Hay
Wichita, Kansas
(Address)

SUBSCRIBED AND SWORN TO before me this 24th day of October, 1955

My commission expires Nov. 3, 1956

Nola Babb
Notary Public.

PLUGGING
FILE SEC. 7 T. 10 R. 18 W.
BOOK 10 LINE 40

WELL LOG

15-163-00834-00-00

NADEL AND GUSSMAN

WISE No. 1

SE SE 7-10-18W
Rooks County, KansasComm: 10-9-55
Comp: 10-19-55

Casing: 168' 8-5/8" w/125 sax

FormationsDepth

Surface
Shale and sand
Shale and shells
Sand and shale
Anhydrite
Shale and shells
Broken lime
Shale and lime
Broken lime
Shale and lime
Lime
Lime and shale
Heebner Shale
Lime and shale
Lansing Lime
Lime
Cherty Conglomerate
Cherty Lime

10
65
750
1000
1640
2470
2500
2800
2895
3347
3393
3396
3399
3438
3450
3710
3753
3790

GEOLOGICAL TOPS

Topeka	3206
Heebner	3396
Toronto	3416
Lansing-Kansas C.	3438
Base Kansas City	3646
Conglomerate	3702

STATE OF KANSAS

COUNTY OF SEDGWICK

SS:


L. C. Hay, of lawful age, states that the above tops and formations and depths are correct as shown by the daily drilling report of the Wise No. 1, located in the SE SE 7-10-18W, Rooks County, Kansas.

Subscribed and sworn to before me this 24th day of October, 1955.

L. C. Hay
L. C. Hay

Nola Babb
Nola Babb, Notary Public

My commission expires Nov. 3, 1956

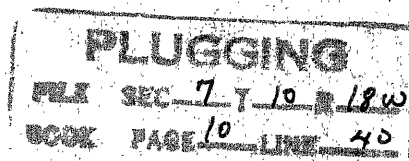

10-29-1955
CONSERVATION DIVISION
Wichita, Kansas