

15-163-21600-00-00

STATE OF KANSAS
STATE CORPORATION COMMISSION


WELL PLUGGING RECORD

Give All Information Completely
Make Required Affidavit
Mail or Deliver Report to
Conservation Division
State Corporation Comm.
245 North Water
Wichita, KS 67202

Rooks County. Sec. 12 Twp. 10S Rge. 18W E/W
Location as "NE/CNW $\frac{1}{4}$ SW $\frac{1}{4}$ " or footage from lines
SE SE SW

Lease Owner Frontier Oil Company
Lease Name Bardot Well No. 1
Office Address 1720 Ks St Bank Bldg., Wichita, Ks 67202
Character of Well (Completed as Oil, Gas or Dry Hole) Dry Hole

Date Well completed March 13, 1982
Application for plugging filed March 13, 1982
Application for plugging approved March 13, 1982
Plugging commenced March 13, 1982
Plugging completed March 13, 1982
Reason for abandonment of well or producing formation D&A

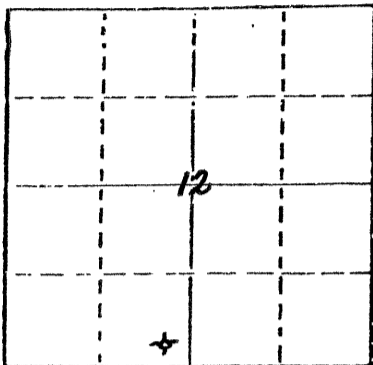

Locate well correctly on above
Section Plat

If a producing well is abandoned, date of last production 19
n/a

Was permission obtained from the Conservation Division or
its agents before plugging was commenced? yes

Name of Conservation Agent who supervised plugging of this well Dennis Hamel
Producing formation n/a Depth to top n/a Bottom n/a Total Depth of Well 3736
Show depth and thickness of all water, oil and gas formations.

OIL, GAS OR WATER RECORDS

CASING RECORD

FORMATION	CONTENT	FROM	TO	SIZE	PUT IN	PULLED OUT
				8 5/8"	269.48	-0-

Describe in detail the manner in which the well was plugged, indicating where the mud fluid
was placed and the method or methods used in introducing it into the hold. If cement or other
plugs were used, state the character of same and depth placed, from _____ feet to
_____ feet for each plug set.

Mud & Gel to 780' Plug @ 780 w/70 sx cmt
Plug @ 270 w/40 sx cmt
Bridge Plug @40' to surf w/10 sx
10 sx in rathole

RECEIVED
STATE CORPORATION COMMISSION
03-17-1982
MAR 17 1982
CONSERVATION DIVISION
Wichita, Kansas

(If additional description is necessary, use BACK of this sheet)

Name of Plugging Contractor Red Tiger Drilling Company

STATE OF Kansas COUNTY OF Sedgwick, ss.
George A. Angle (~~employee of owner~~) (owner or operator)

of the above-described well, being first duly sworn on oath, says: That I have knowledge of
the facts, statements, and matters herein contained and the log of the above-described well
as filed and that the same are true and correct. So help me God.

(Signature) George A. Angle
1720 Ks St Bank Bldg., Wichita, Kansas 67202
(Address)

SUBSCRIBED AND SWORN TO before me this 15th day of March, 19 82

Jean Stocks
Notary Public.

My commission expires 5-14-85

