


STATE OF KANSAS
STATE CORPORATION COMMISSION

WELL PLUGGING RECORD

Give All Information Completely
Make Required Affidavit
Mail or Deliver Report to:
Conservation Division
State Corporation Commission
800 Bitting Building
Wichita, Kansas

NORTH

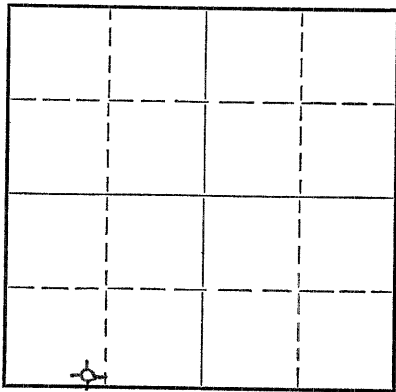

Locate well correctly on above
Section Plat

Rooks County. Sec. 4 Twp. 10 Rge. 18 (E) W (W)
Location as "NE/CNW $\frac{1}{4}$ SW $\frac{1}{4}$ " or footage from lines SE $\frac{1}{4}$ SW $\frac{1}{4}$ SW $\frac{1}{4}$
Lease Owner D & M Drilling Company, Inc.
Lease Name Minnie E. Allison Well No. 1
Office Address Box 247, Great Bend, Kansas
Character of Well (completed as Oil, Gas or Dry Hole) Dry hole
Date well completed May 24 19. 53
Application for plugging filed May 24 19. 53
Application for plugging approved May 24 19. 53
Plugging commenced May 24 19. 53
Plugging completed May 24 19. 53
Reason for abandonment of well or producing formation Dry hole

If a producing well is abandoned, date of last production _____ 19. _____
Was permission obtained from the Conservation Division or its agents before plugging was commenced? Yes

Name of Conservation Agent who supervised plugging of this well Eldon Petty
Producing formation _____ Depth to top _____ Bottom _____ Total Depth of Well 3765 Feet
Show depth and thickness of all water, oil and gas formations.

OIL, GAS OR WATER RECORDS

CASING RECORD

Formation	Content	From	To	Size	Put In	Pulled Out
				<u>8 5/8</u>	<u>186</u>	<u>0</u>

Describe in detail the manner in which the well was plugged, indicating where the mud fluid was placed and the method or methods used in introducing it into the hole. If cement or other plugs were used, state the character of same and depth placed, from _____ feet to _____ feet for each plug set.

Filled hole with heavy mud up to 175'. Run Halliburton plug, 1/2 sack hulls, 15 sacks cement @ 175'. Filled hole to 40' with mud. Run Halliburton plug, 1/2 sack hulls, 10 sacks cement @ 40'. Plugging completed 9:30 P.M.

05-28-1953

(If additional description is necessary, use BACK of this sheet)

Correspondence regarding this well should be addressed to D & M Drilling Company, Inc.
Address P. O. Box 247, Great Bend, Kansas

STATE OF Kansas, COUNTY OF Barton, ss.

Don S. Packer (employee of owner) or (~~owner~~) of the above-described well, being first duly sworn on oath, says: That I have knowledge of the facts, statements, and matters herein contained and the log of the above-described well as filed and that the same are true and correct. So help me God.

(Signature) [Signature]

P. O. Box 247, Great Bend, Kansas
(Address)

SUBSCRIBED AND SWORN to before me this 27th day of May, 19. 53

My commission expires January 30, 1957

[Signature]
Notary Public.

PLUGGING
FILE SEC 4 T 10 R 18W
BOOK PAGE 104 LINE 2

15-163-00508-00-00

MINNIE E. ALLISON

SE/4 SW/4 SW/4 of Section 4-10S-18W Rooks County, Kansas

Rigged up Rotary Tools 5/13/53
Tore down Rotary Tools 5/24/53

Run 6 Jts. (189') new 8 5/8" 8 Rd. Thd. Surface Pipe. Cemented with 150 sacks cement. Cement circulated. Plugged down 6:30 A.M.
Plugged 5/24/53. Pushed first plug to 175'. Dumped 1/2 sack hulls, mixed 15 sacks of cement with water. Filled hole with mud to 40'. Pushed plug to 40'. 1/2 sack hulls, 10 sacks cement Finished @ 9:30 P.M.

<u>FORMATION</u>	<u>FROM</u>	<u>TO</u>
Shale & sand	0'	186'
Shale	186	560
Dakota sand	560	1030
Iron	1030	1038
Sand	1038	1265
Shale & redbed	1265	1568
Anhydrite	1568	1616
Shale	1616	2140
Lime & shale	2140	2290
Lime	2290	2360
Shale	2360	2510
Lime & shale	2510	2635
Shale	2635	2810
Lime & shale	2810	2905
Shale & lime streaks	2905	3095
Lime	3095	3536
Lime & shale streaks	3536	3576
Lime	3576	3638
Conglomerate	3638	3663
Lime, Chert streaks & shale	3663	3720
Lime & shale	3720	3759
Lime	3759	3765 TD

I, June Swaney, do hereby certify that the foregoing log is true and correct, to the best of my knowledge and belief.

RECEIVED
STATE COMMISSION

June Swaney
CONSERVATION

Subscribed and sworn to before me this 27th day of May, 1953.

Dorothy M. Kasper

My commission expires: Jan. 30, 1957

PLUGGING
FILE SEC. 4 T. 10 R. 18W
BOOK PAGE 104 LINE 2